


T.10 S., R.1 W., W.M.

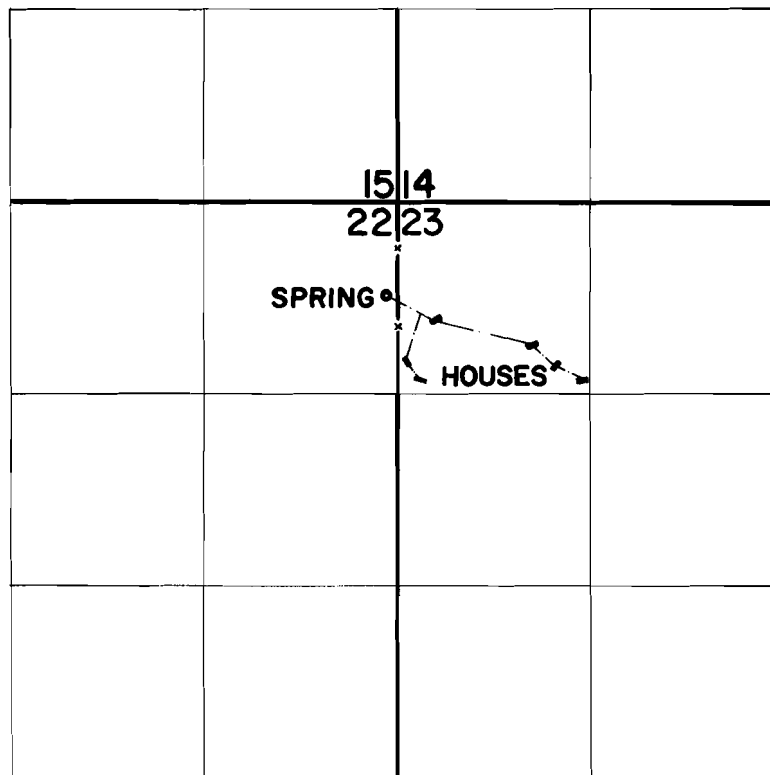

SPRING LOCATED: 640' S & 70' W FROM NE COR. SEC 22.

FINAL PROOF SURVEY
UNDER

Application No. 47240 Permit No. 34955
IN NAME OF

RONALD D. AND MARLENE JANTZ

Surveyed JUNE 20 1973, by D. NORBY