


T.11S., R.2W., W.M.

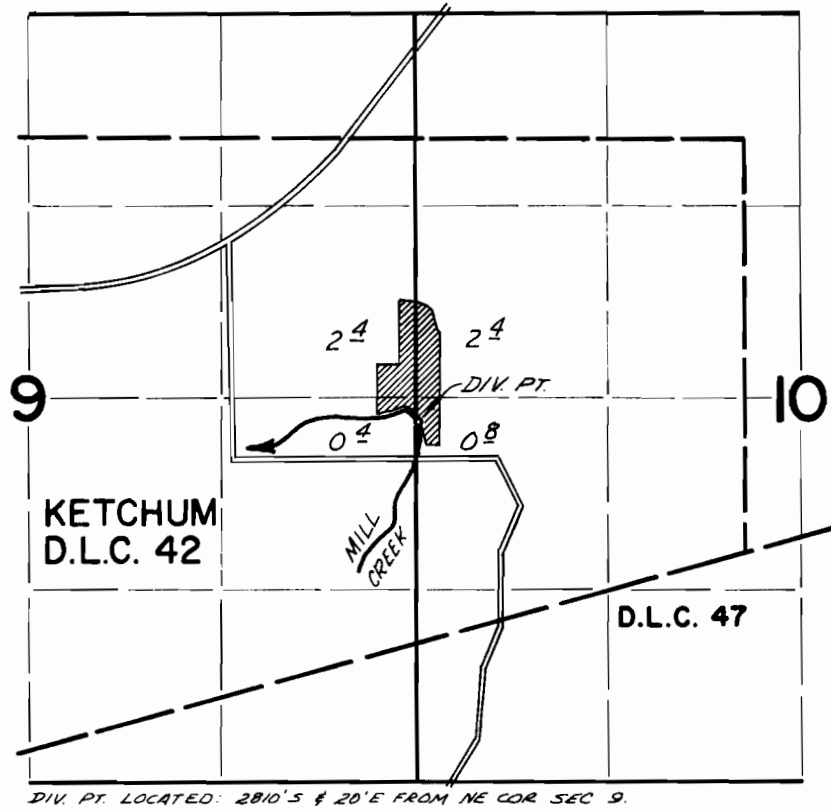

FINAL PROOF SURVEY
UNDER

Application No. 47009 Permit No. 35168
IN NAME OF

HOWARD S. AND VENA J. PLATTNER

Surveyed June 18, 1973, by D. Norby