



T.11S., R.4W., W.M.

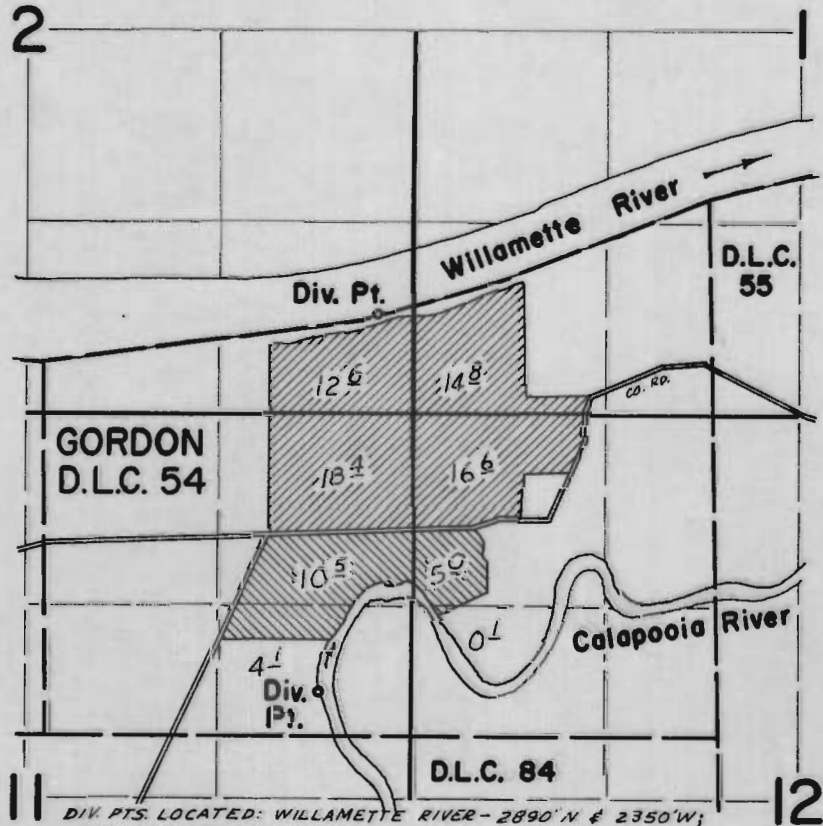

DIV. PTS. LOCATED: WILLAMETTE RIVER - 2890' N & 2350' W;
 CALAPOOIA RIVER - 300' N & 2730' W; BOTH FROM SE COR.
 GORDON DLC 54.

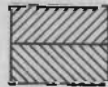

Willamette River
Calapooia River

FINAL PROOF SURVEY UNDER

Application No. 47831 Permit No. 35854
 IN NAME OF

A. A. & MARANNE STRAUMFJORD

Surveyed Oct. 1, 1973, by D. Norby