


T. 13 S. R. 1 E. W. M.

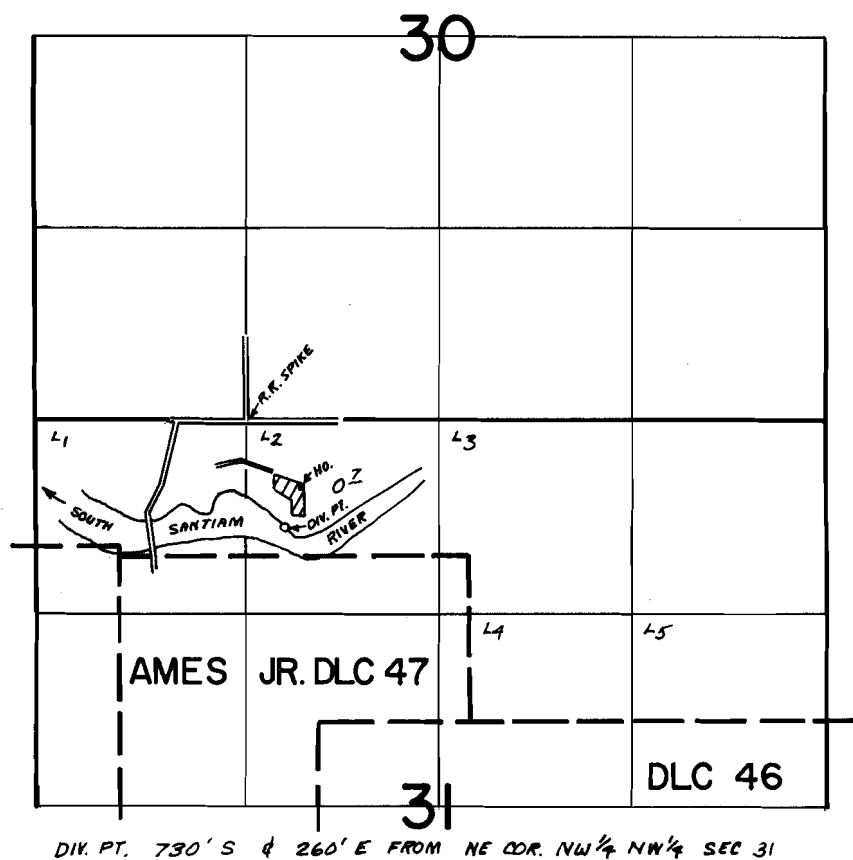

FINAL PROOF SURVEY

UNDER

Application No. 48218 Permit No. 36211
IN NAME OF

DUANE W. NORRIE

Surveyed MAY 8 1972, by R.G. MUCKEN