


T.12S.R.1W.W.M.

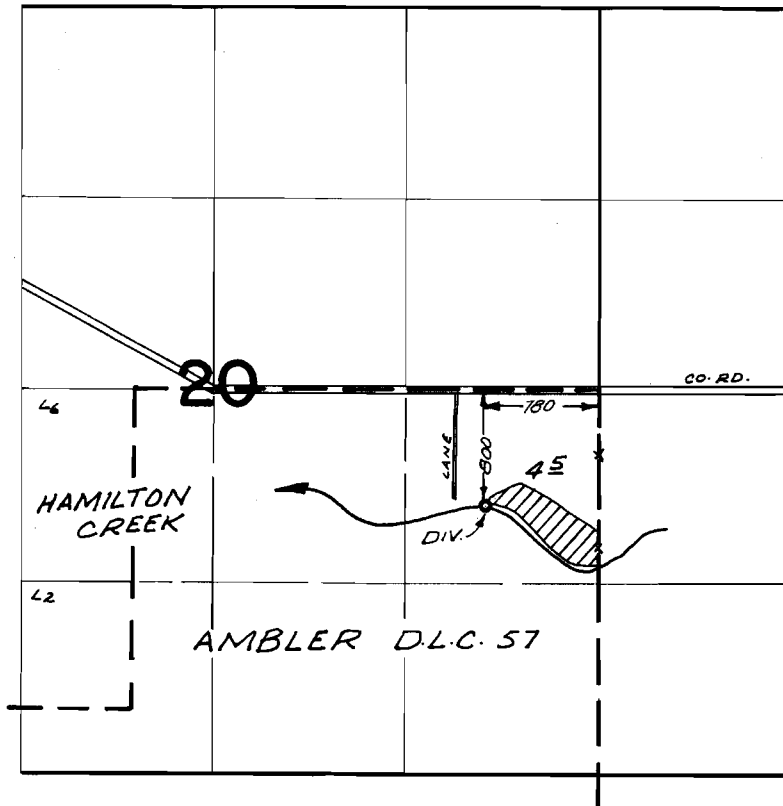

FINAL PROOF SURVEY UNDER

Application No. 48497 Permit No. 36391
IN NAME OF

CLEMENS F. SLING

Surveyed MAY 9, 1973, by R. MUGGEN