


T. 13S. R. 1 E. W.M.

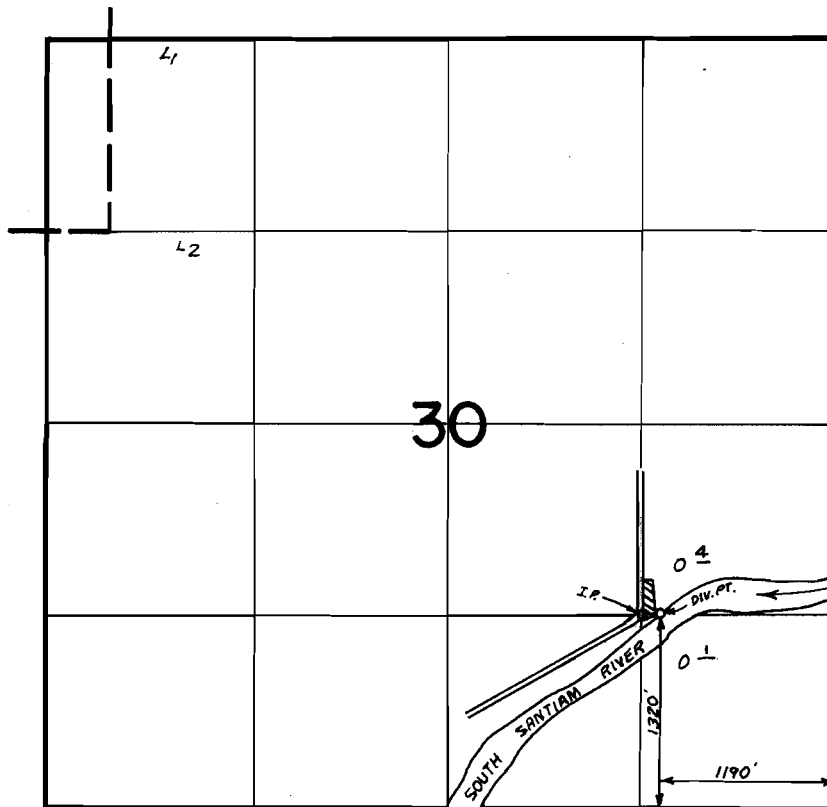

FINAL PROOF SURVEY
UNDER

Application No. 48562 Permit No. 36444
IN NAME OF

L. H. SUHRE

Surveyed MAY 11 1973, by R. G. MUCKEN