


T.15S.R.3W.W.M.

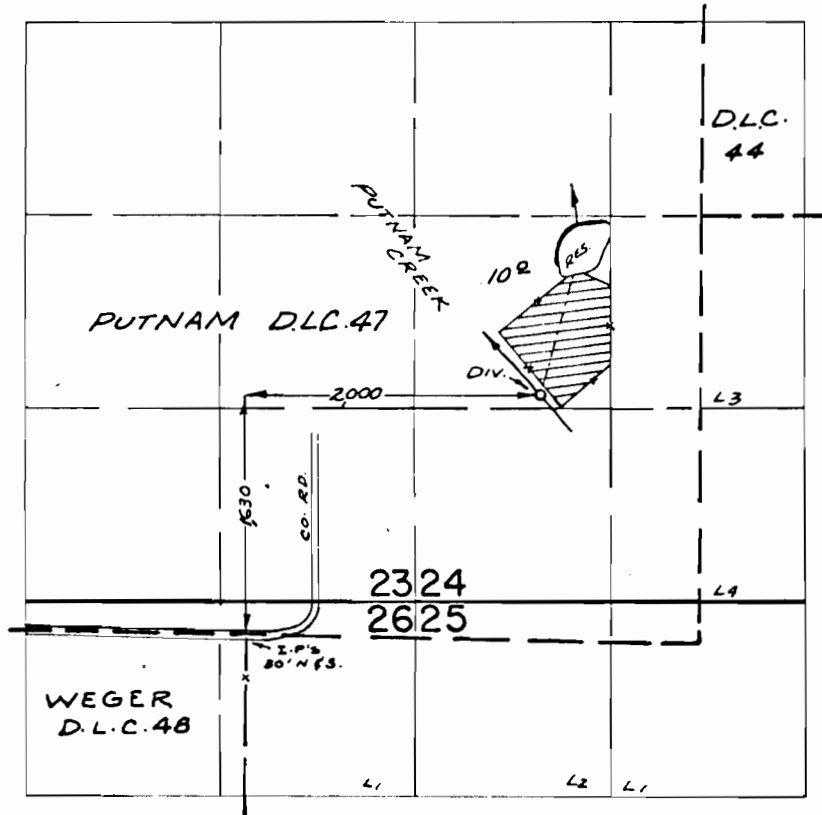

DIV. PTS. LOC: CREEK - 1630' N & 2000' E; RES - 2790' N & 2240' E, BOTH FROM NE. COR. WEGER D.L.C. 48

FINAL PROOF SURVEY UNDER

45072 33681
Application No. R-45127 Permit No. R-5321
IN NAME OF

GROVER & ORA JELDEN

Surveyed OCT. 23, 1973, by R. MUCKEN