


T.13S.R.2W.W.M.

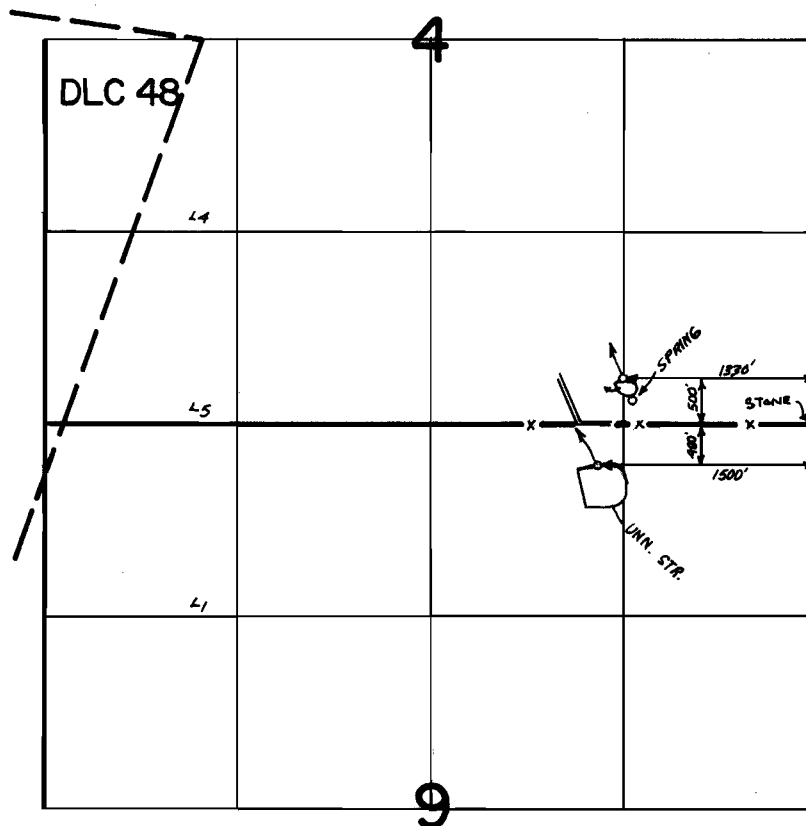

**FINAL PROOF SURVEY**  
UNDER

Application No. R-48067 R-46252 Permit No. R-5656 R-5441  
IN NAME OF

RALPH K. WATTS

Surveyed MAY 10 1973, by R.G. MUCKEN