


T.20S. R.42E. W.M.

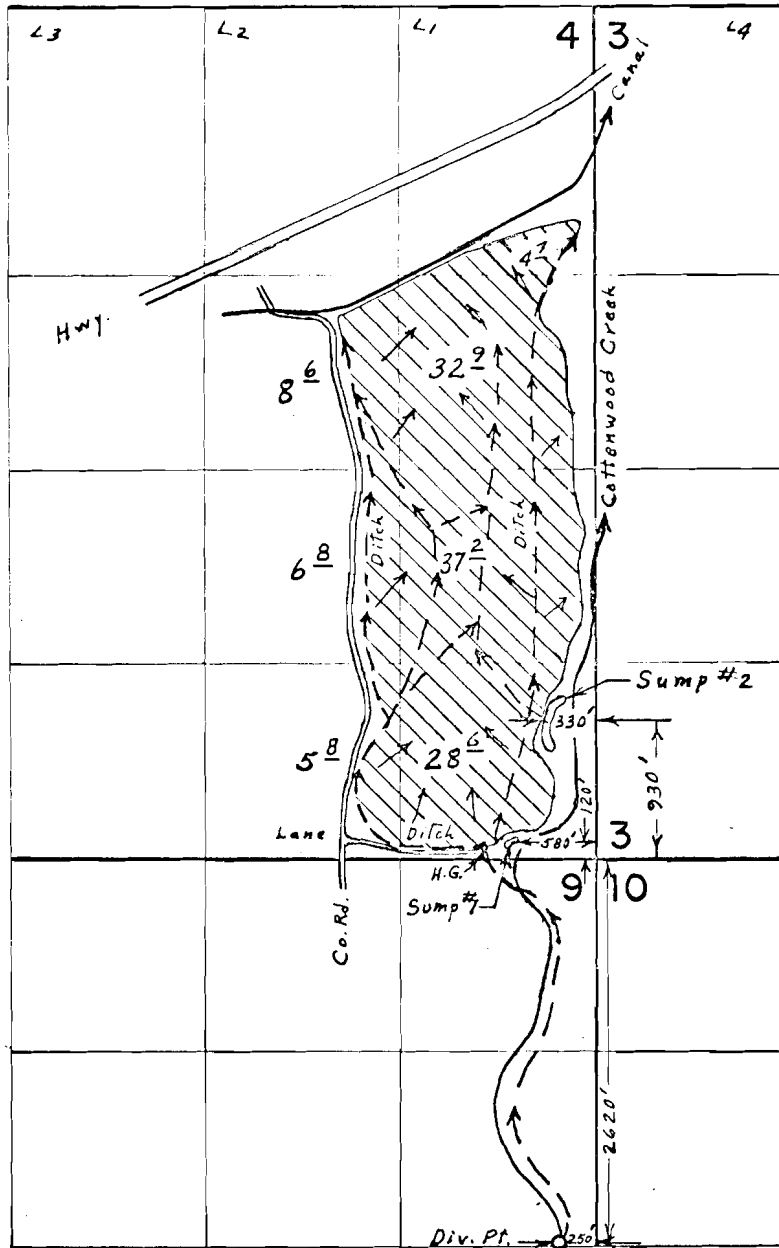

FINAL PROOF SURVEY
UNDER

G-4235 G-3997
Application No. 45297 Permit No. 33409
IN NAME OF

STEVE GACEY

Surveyed Aug. 25, 1973, by L. E. Gould.