


T.18S.,R.47E.,W.M.

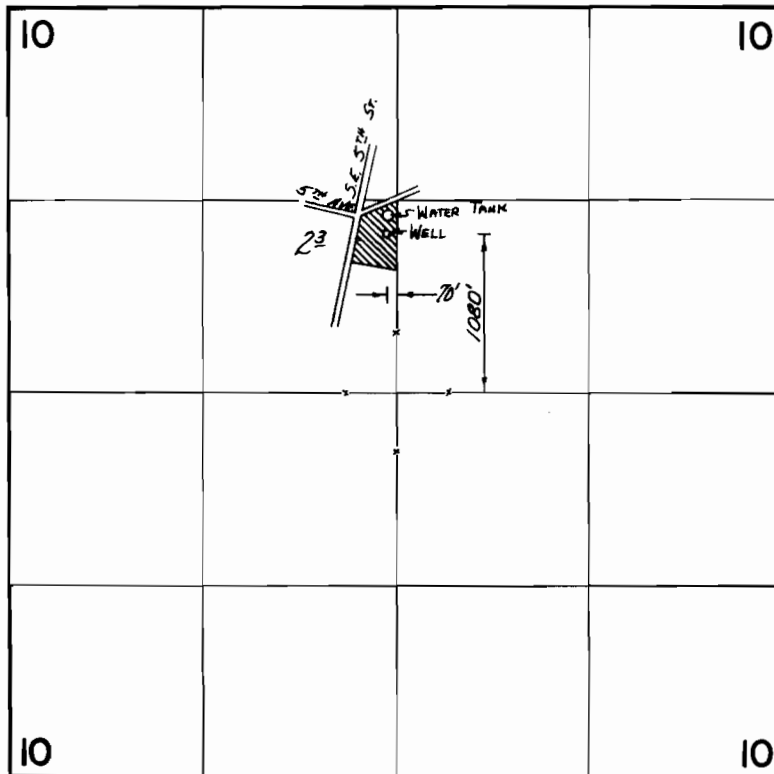

FINAL PROOF SURVEY
UNDER

Application No. G-4857 Permit No. G-4573
IN NAME OF

CITY OF ONTARIO

Surveyed May 28 1973, by D. Noray