


T.15S.,R.45E.,W.M.

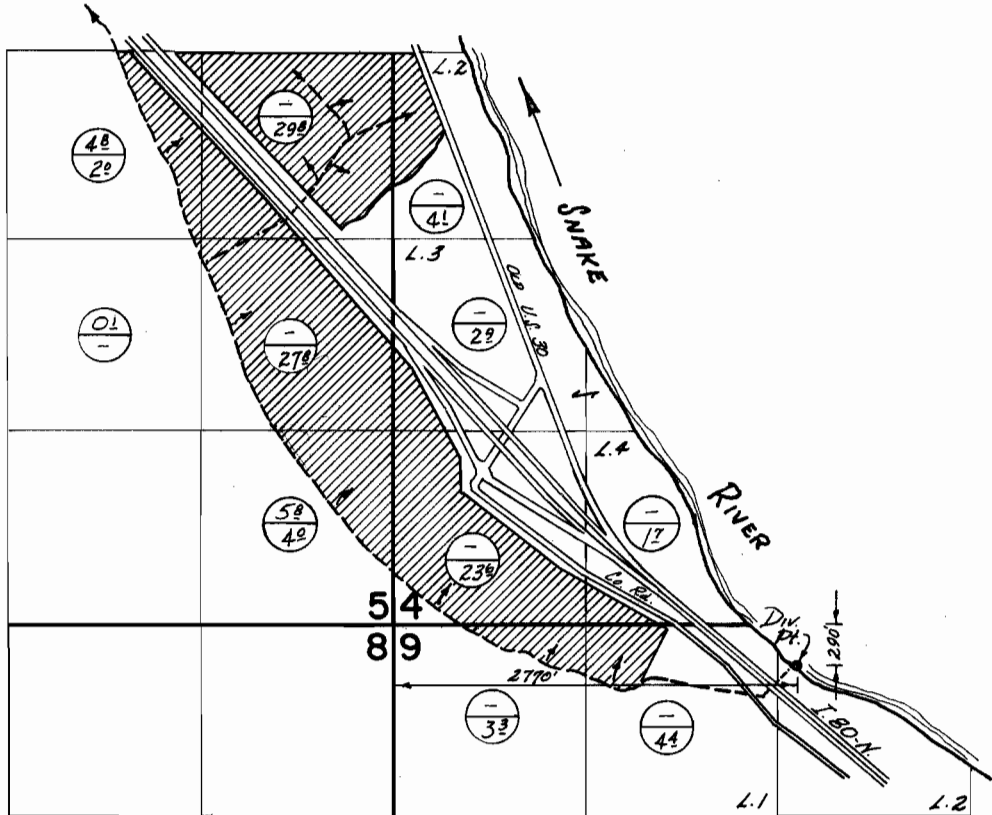

PRIMARY
SUPPLEMENTAL

FINAL PROOF SURVEY
UNDER

Application No. 31671 Permit No. 24981
IN NAME OF

CLYDE RAMSEY

Surveyed May 30 1973, by D. NORBY