


T.4S. R.1W. W.M.

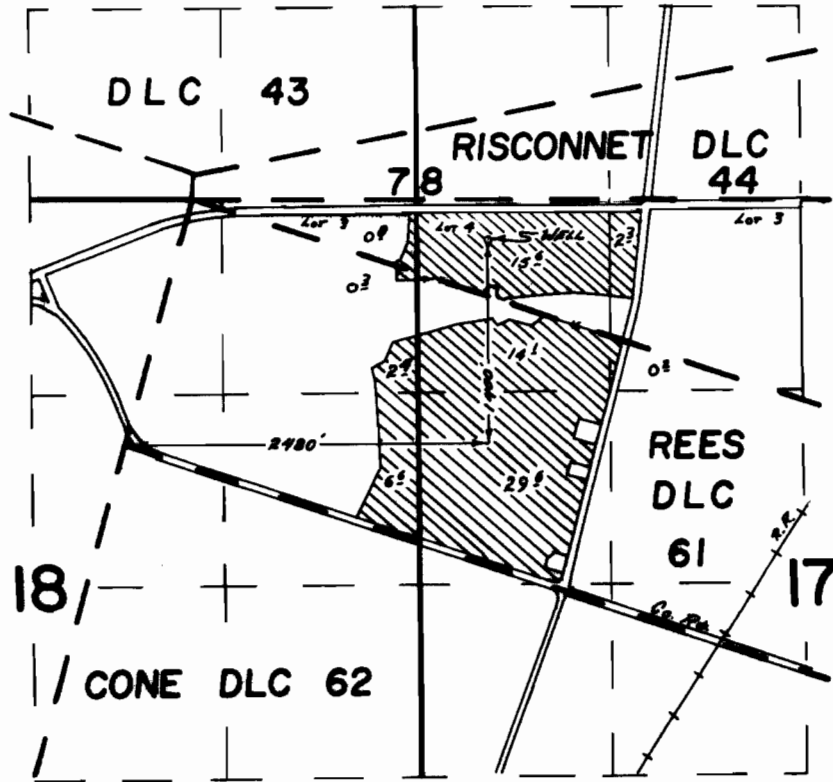

FINAL PROOF SURVEY UNDER

Application No. G-4383 Permit No. G-4135
IN NAME OF

LINWOOD CROMWELL

Surveyed June 4, 1953, by R. G. MUCKEN