


T.7S. R.1E. W.M.

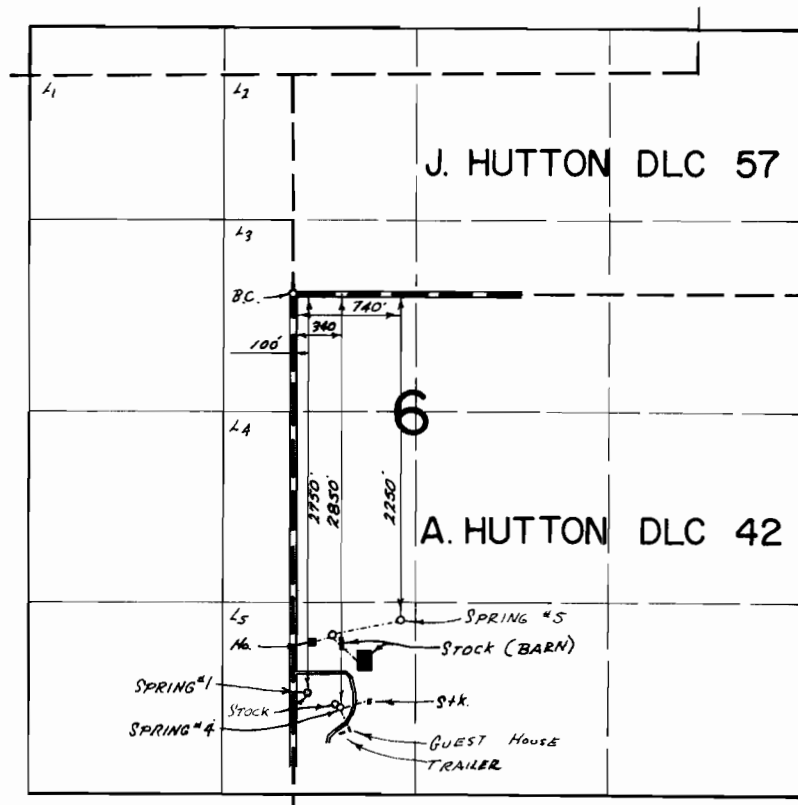

FINAL PROOF SURVEY
UNDER

Application No. 42610... Permit No. 31832...
IN NAME OF

Barbara Phillips

Surveyed April 12 1974, by T. J. PAUL