


31074
42034

T. 3 S. R. 26 E. W.M.

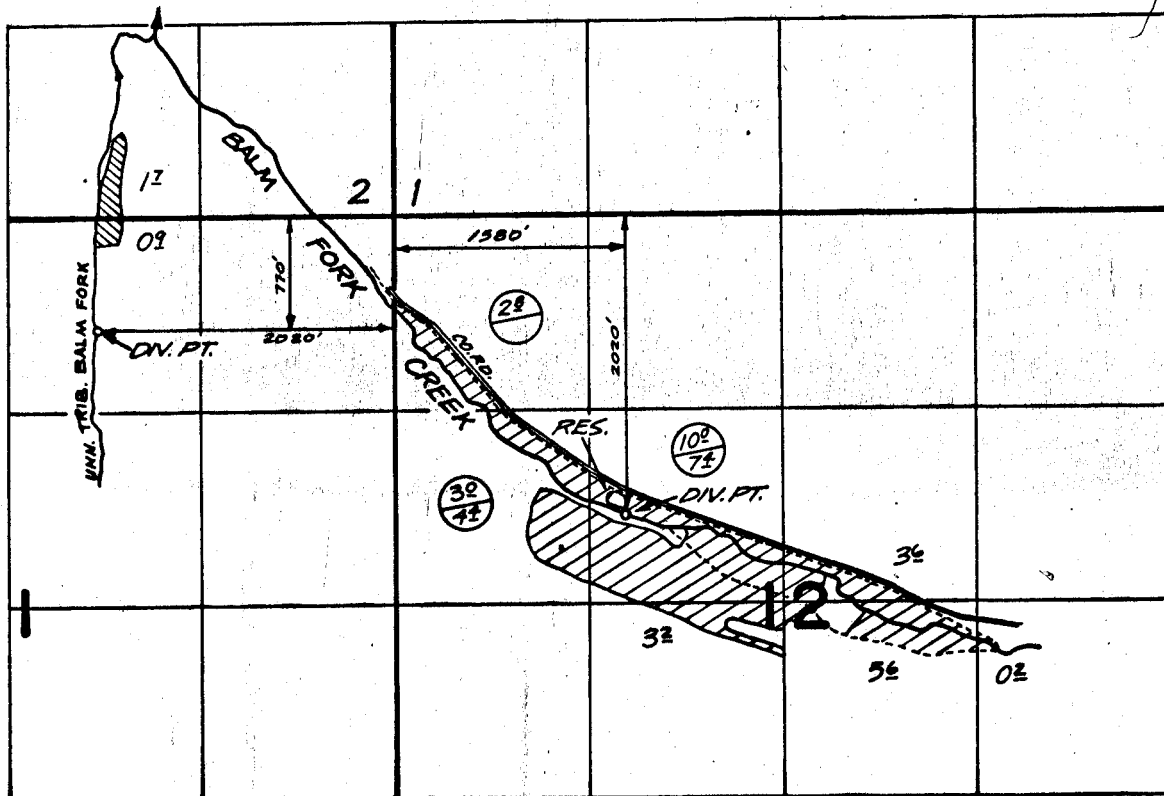

PERMIT 31074 PERMIT 31075

CERTIFICATE 251
PERMIT 31074

FINAL PROOF SURVEY UNDER

Application No. 41635 Permit No. 31074
41636 Permit No. 31075
IN NAME OF

A.L. OSMIN

Surveyed MAY 10 1971, by R. MUCKEN
MAY 7 1974 D. NORBY