


T.9&10.S. R.4W. W.M.

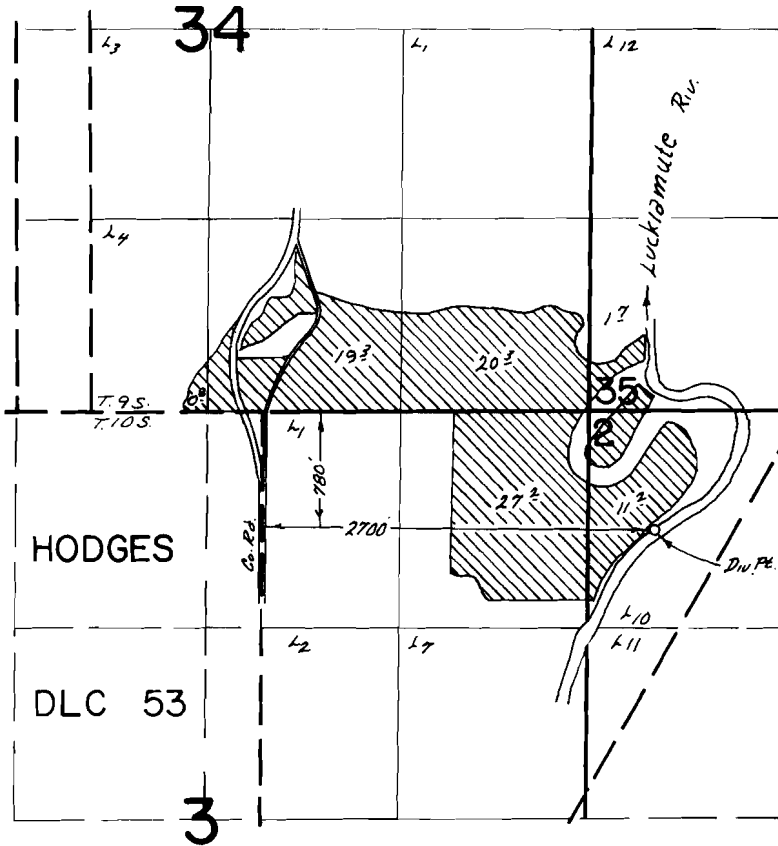

**FINAL PROOF SURVEY**  
UNDER

Application No. 45171 Permit No. 33749  
IN NAME OF

DAVID W. & GLADYS M. HAGERBAUMER

Surveyed March 26, 1973, by R.B. Mucken