


T.9S. R.5W. W.M.

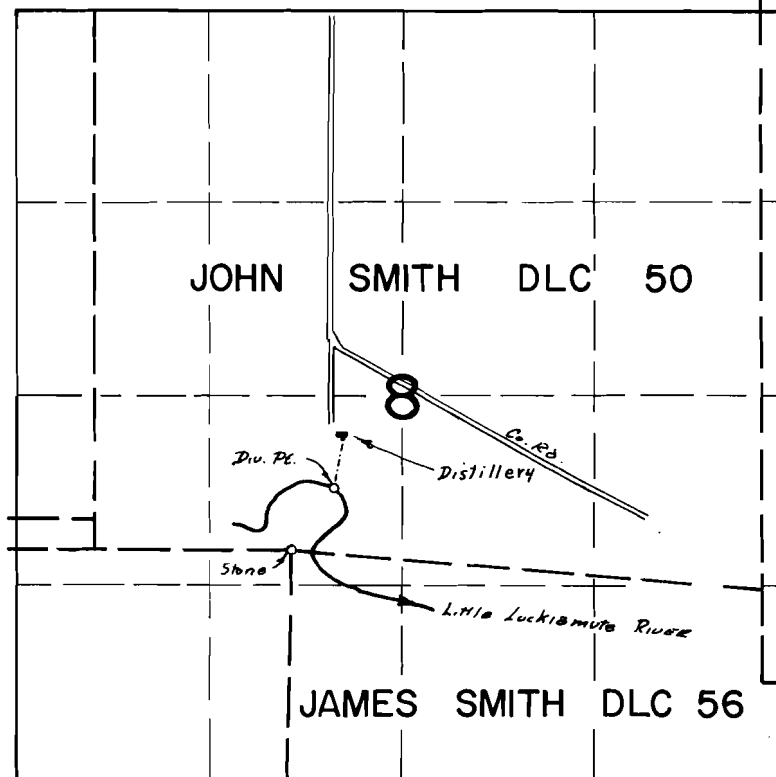

Div. Pl. Loc. 430' N & 300' E From NW Cor James Smith DLC 56

FINAL PROOF SURVEY
UNDER

Application No. 46240 Permit No. 34547
IN NAME OF

VERN RATZLAFF

Surveyed March 29 1973, by R.G. Mucken