


T.9S. R.4W. W.M.

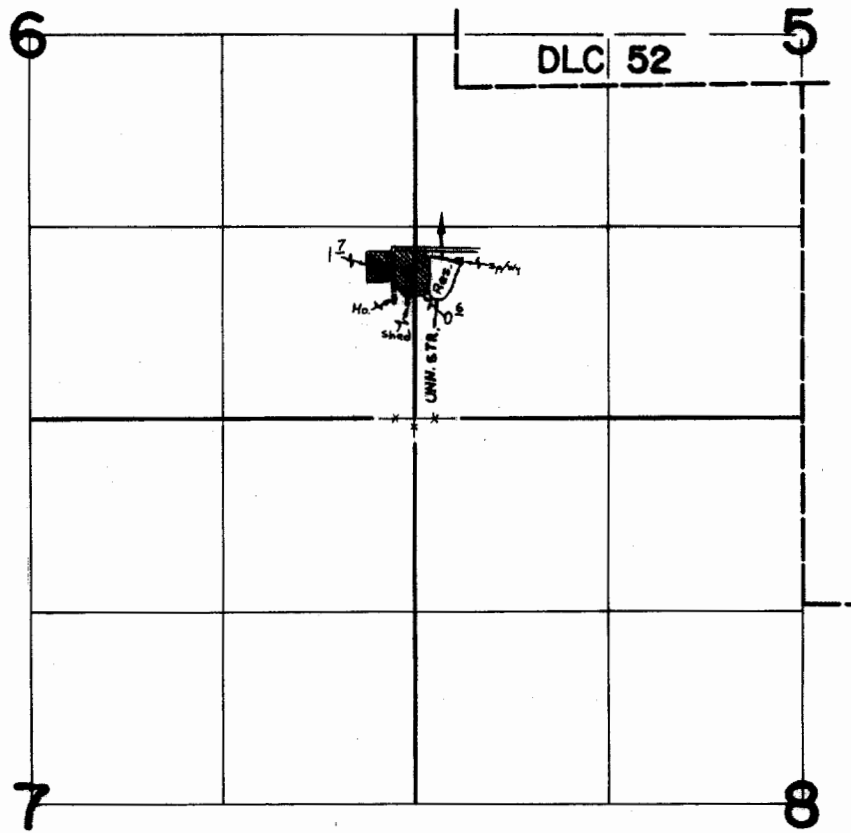

Div Pt. Loc: 1090' N. ϵ 180' E. from SW cor. Section 5

FINAL PROOF SURVEY
UNDER

Application No. 44860 R-44859 Permit No. 33544 R-5300
IN NAME OF

RICHARD S. & EUNICE HOFFMAN

Surveyed MARCH 29 1974, by R. MUCKEN