


T.6&7S. R.5W. WM.

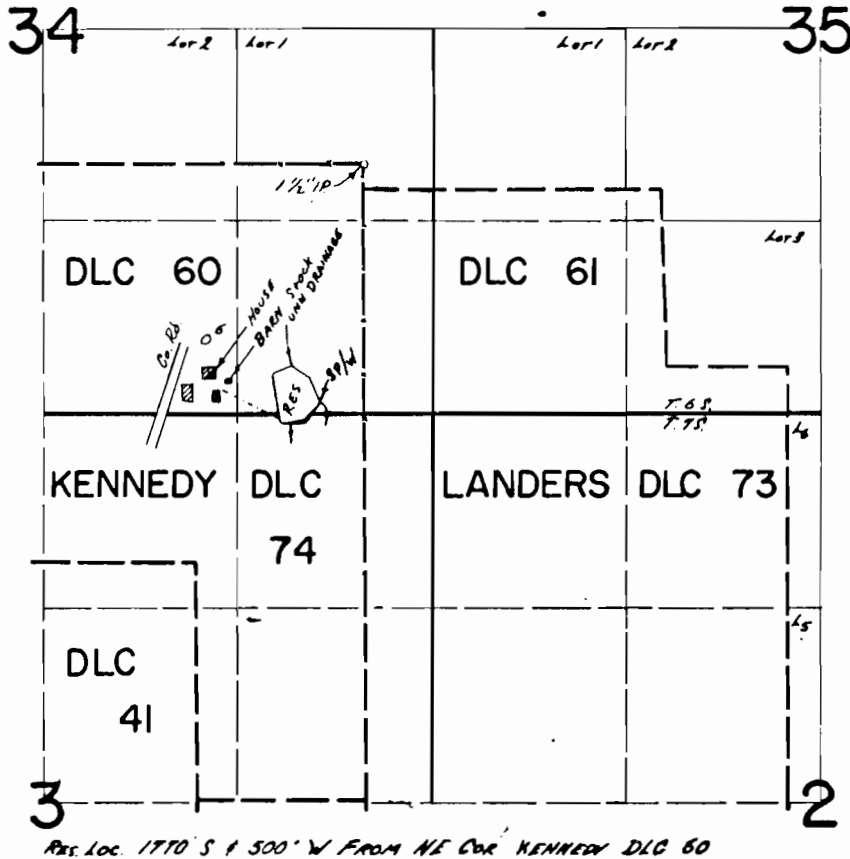

Ref. Loc. 1770 S + 500' W FROM NE COR KENNEDY DLC 60

FINAL PROOF SURVEY UNDER

R-46052 R-5476
 Application No.46053 Permit No.34390
 IN NAME OF

..... JOHN E. WALL

Surveyed April 23 1974, by T. J. PAUL.....