


T.3N.R.10W.W.M.

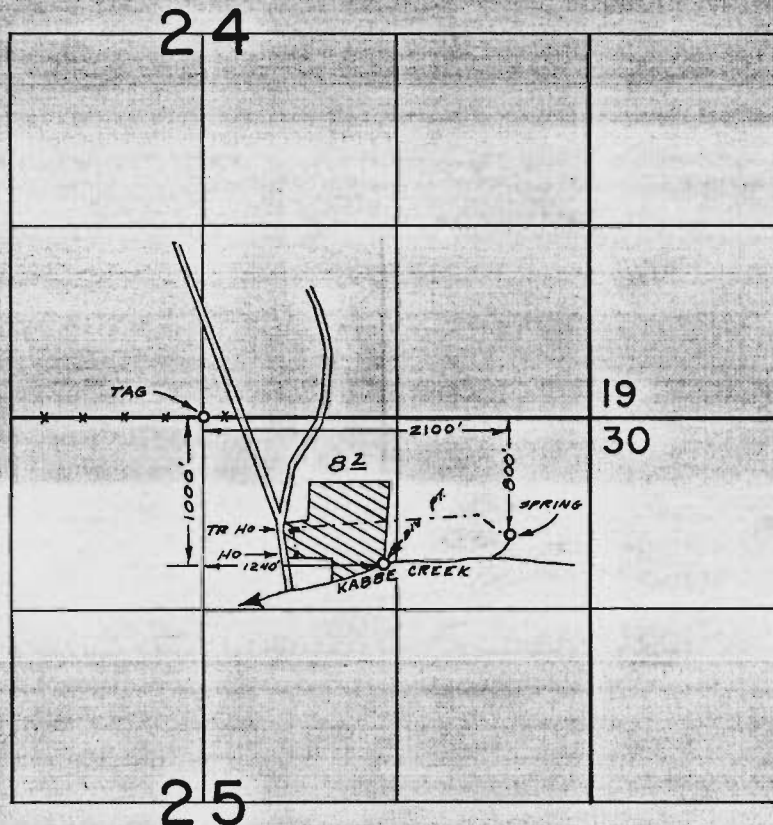

FINAL PROOF SURVEY
UNDER

Application No. 52932 41755 Permit No. 39964 31170
IN NAME OF

HENRY MARTI

Surveyed MAY 2 19 73, by R. MUCKEN
INSPECTED JUL. 27, 1977 BY L.H. NUNN