


6-4880

43047

T.6N. R.35E. W.M.

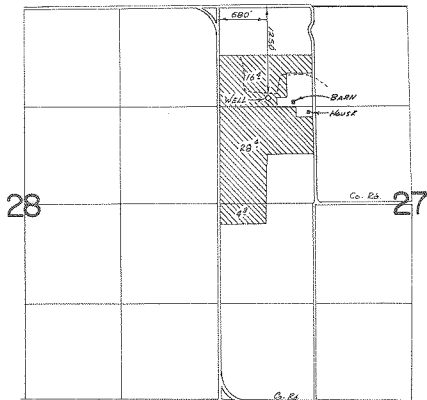

FINAL PROOF SURVEY
UNDER

Application No. G-5147... Permit No. G-4880
IN NAME OF

EVA & ALFRED BIXBY

Surveyed APRIL 10, 1973, by R.G. MUCKEN