


T.6S.R.21E.W.1.

P. 32107
42052

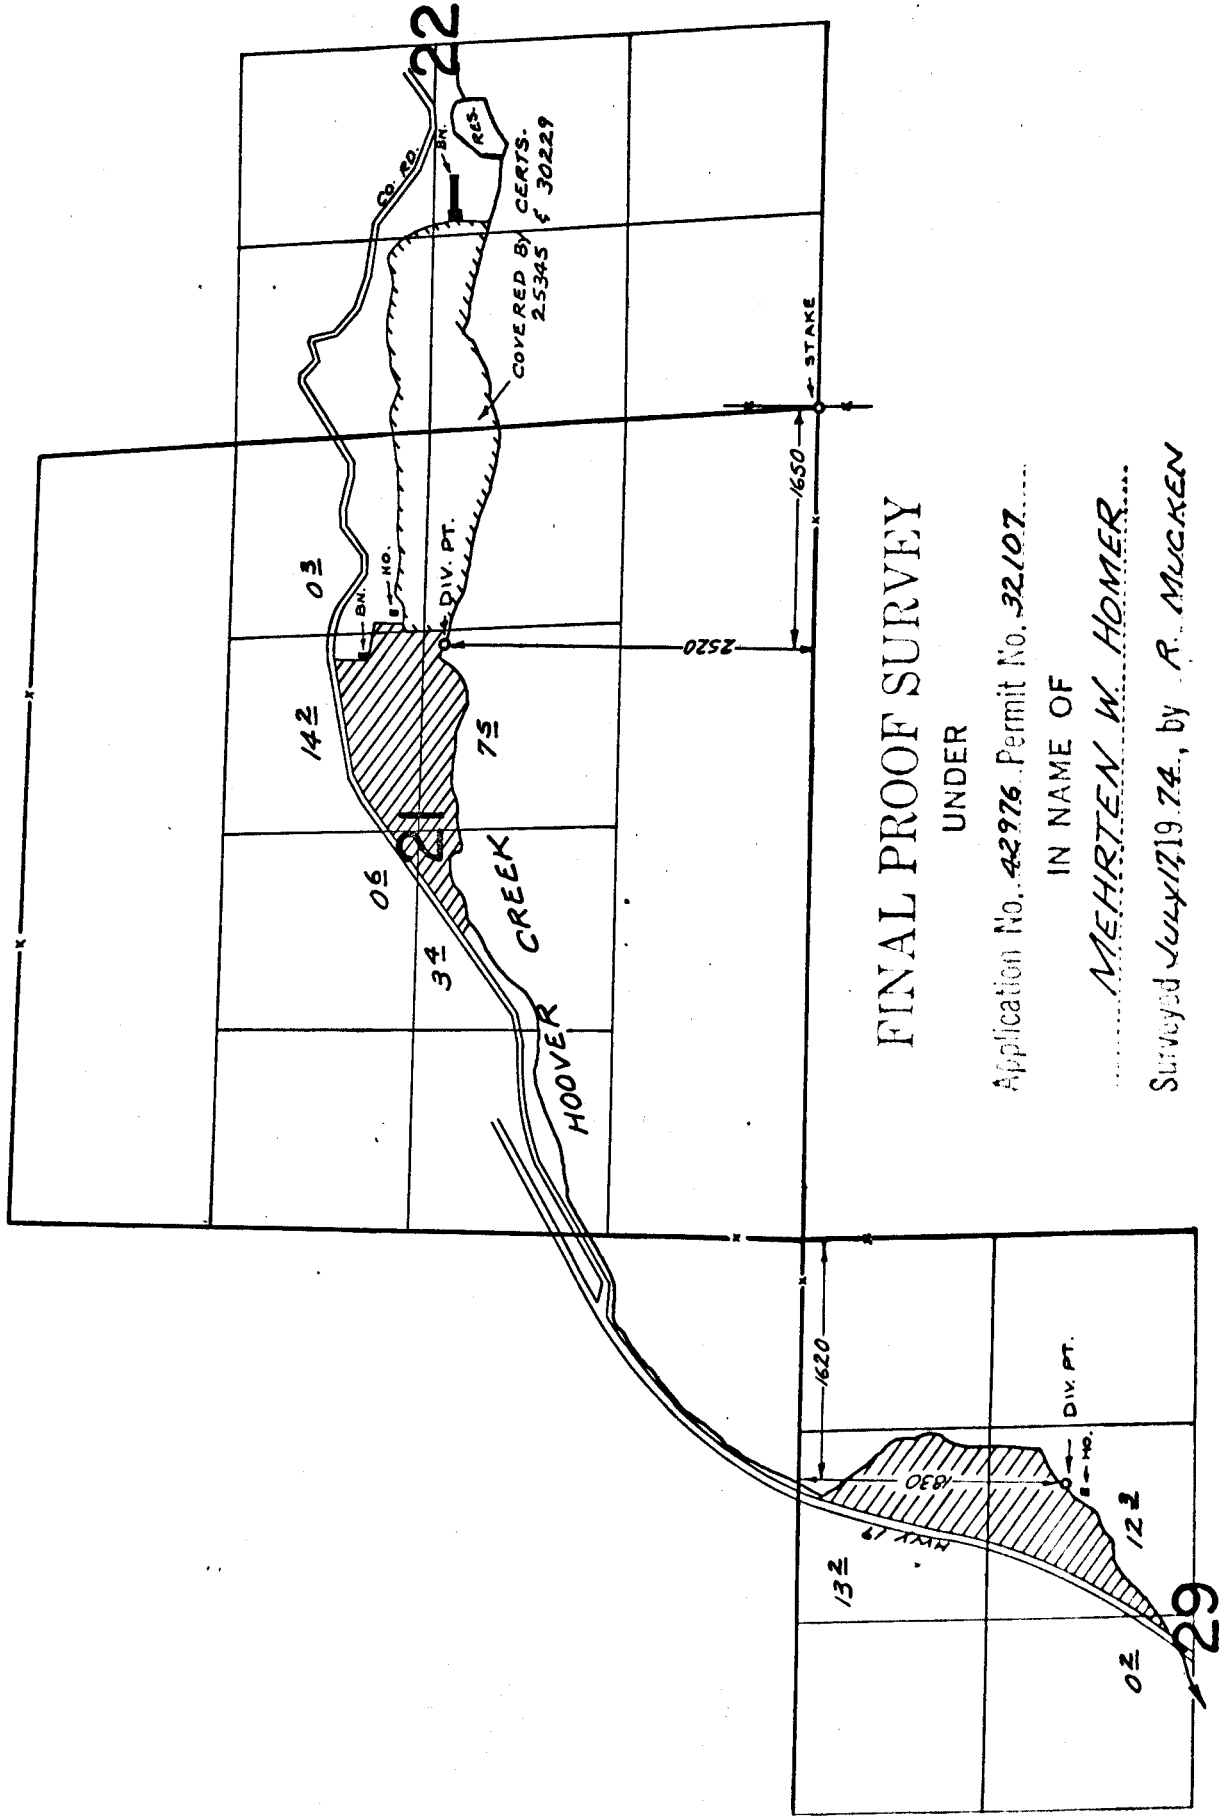

FINAL PROOF SURVEY

UNDER

Application No. 42976 Permit No. 32107

IN NAME OF

MEHRTEN W. HOMER

Surveyed July 19 74., by R. MUCKEN