


T.5 S. R.3 W. W.M.

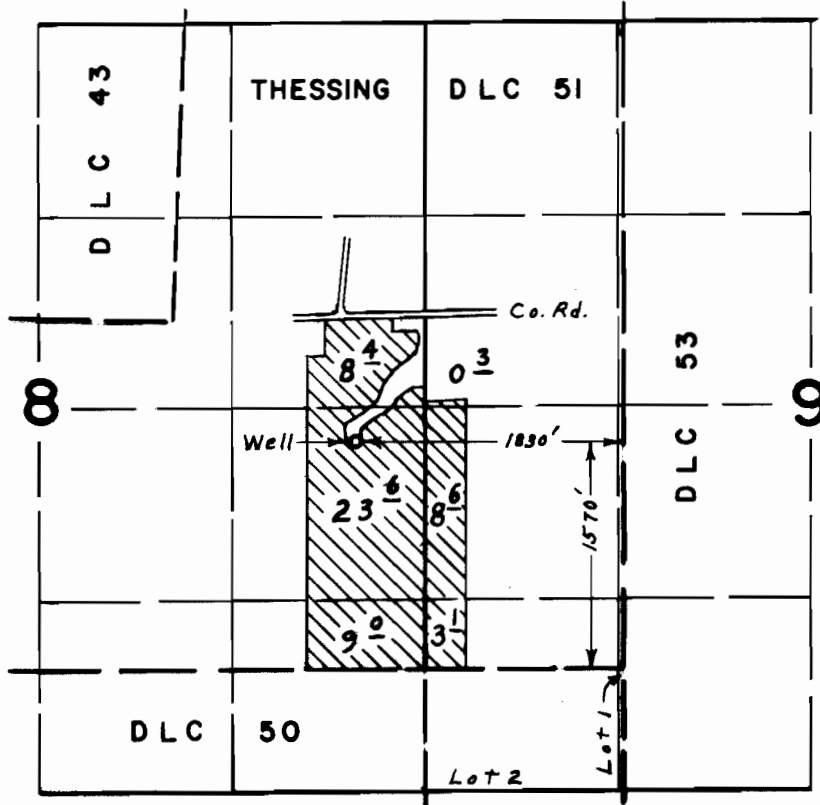

FINAL PROOF SURVEY UNDER

Application No. G-4952 Permit No. G-4674
IN NAME OF

MAURICE HENRY GOODRICH

Surveyed March 21, 1973, by L. E. Gould....