


T.4 N. R.3 E. W.M.

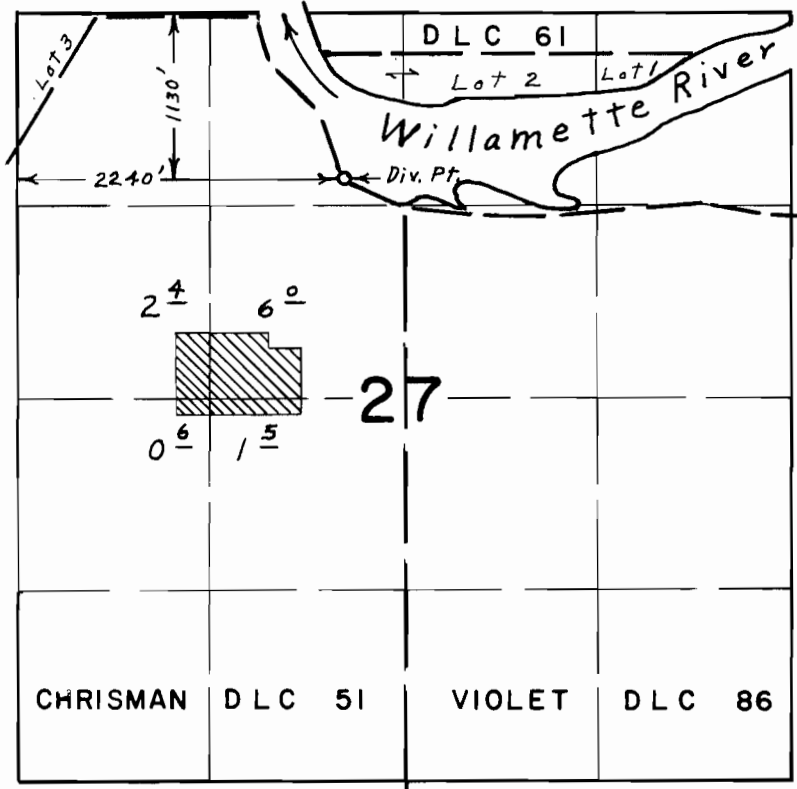

FINAL PROOF SURVEY
UNDER

Application No. 43255 Permit No. 32355
IN NAME OF

T. E. YOUNGBLOOD

Surveyed March 16, 1973, by L. E. Gould