


T.5S. R.3W. W.M.

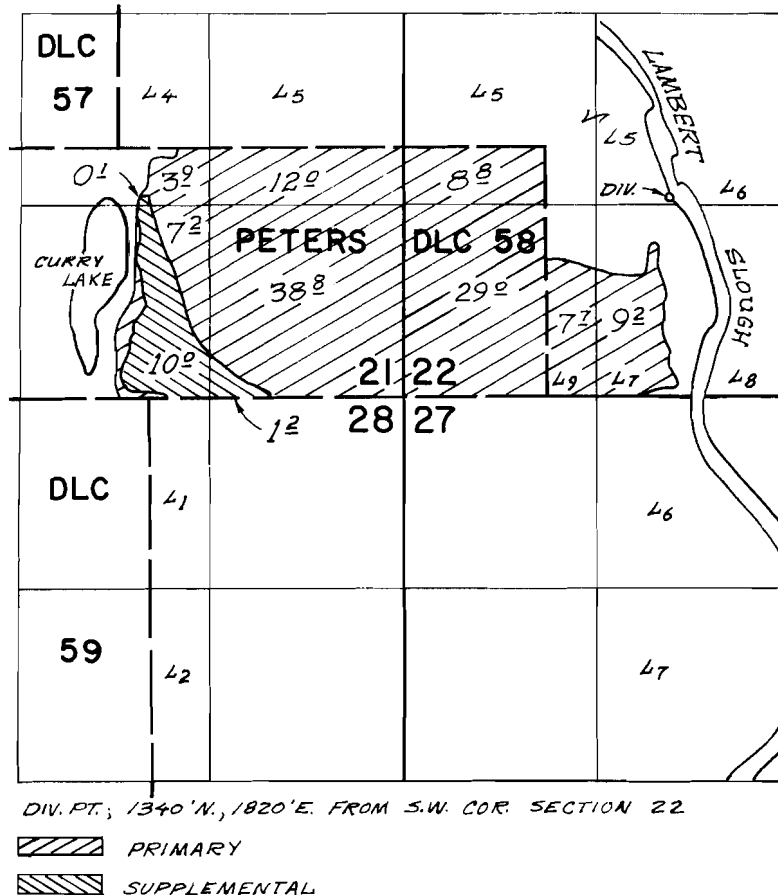

FINAL PROOF SURVEY
UNDER

Application No. 45976 Permit No. 34343
IN NAME OF

J. W. EDIGER

Surveyed SEPT. 6 1973, by L. GOULD