T.3S. R.3W. W.M.

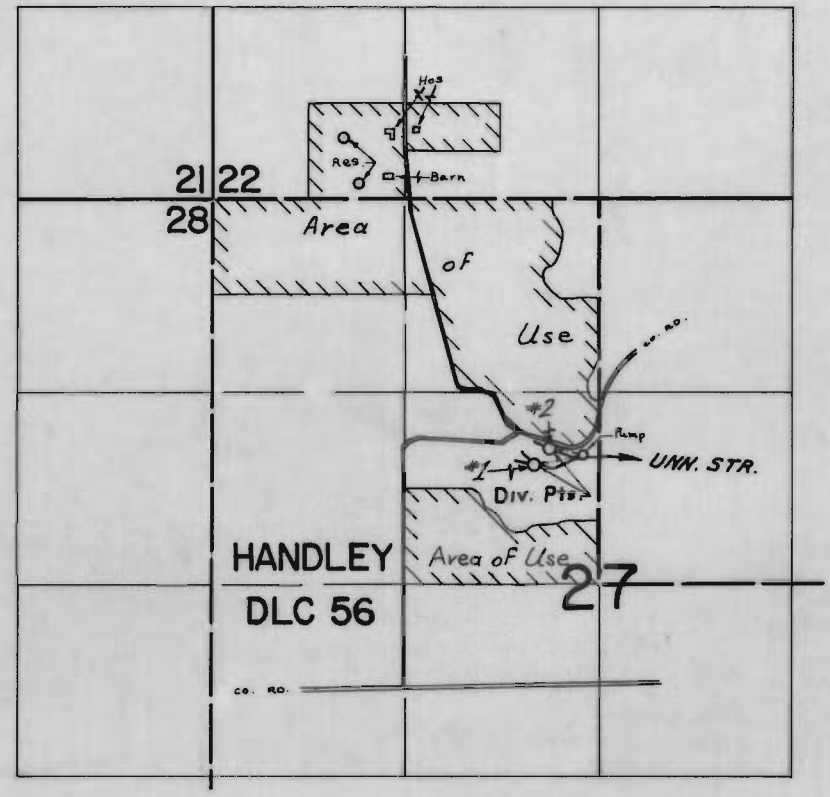

Div. Pts. Loc: 930'N. & 340'W., 820'N. & 450'W. From cen. Sec. 27

FINAL PROOF SURVEY
UNDER

Application No. 47813 Permit No. 35242
IN NAME OF

JOHN L. MEYER

Surveyed MARCH 29, 1973, by L.E. GOULD

DFQ-2LL-241 & DFQ-2D-151