


T.5S. R.4W. W.M.

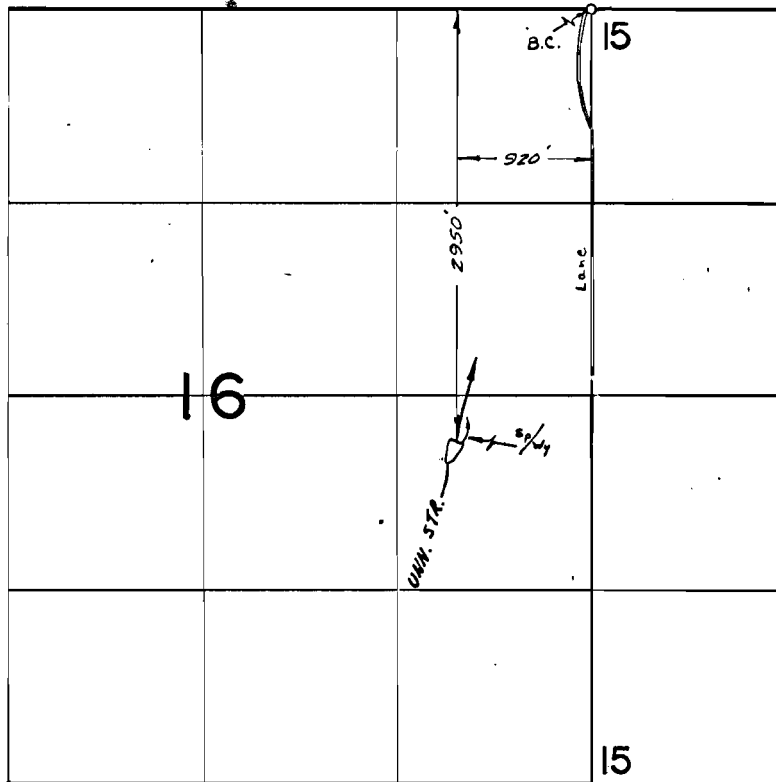

FINAL PROOF SURVEY
UNDER

Application No. 43898 R-43455 Permit No. 32556 R-4997
IN NAME OF

CHESTER A. STRINGER JR.

Surveyed MAY 30, 1973, by R. G. MUCKEN