T.5S. R.4W. W.M.

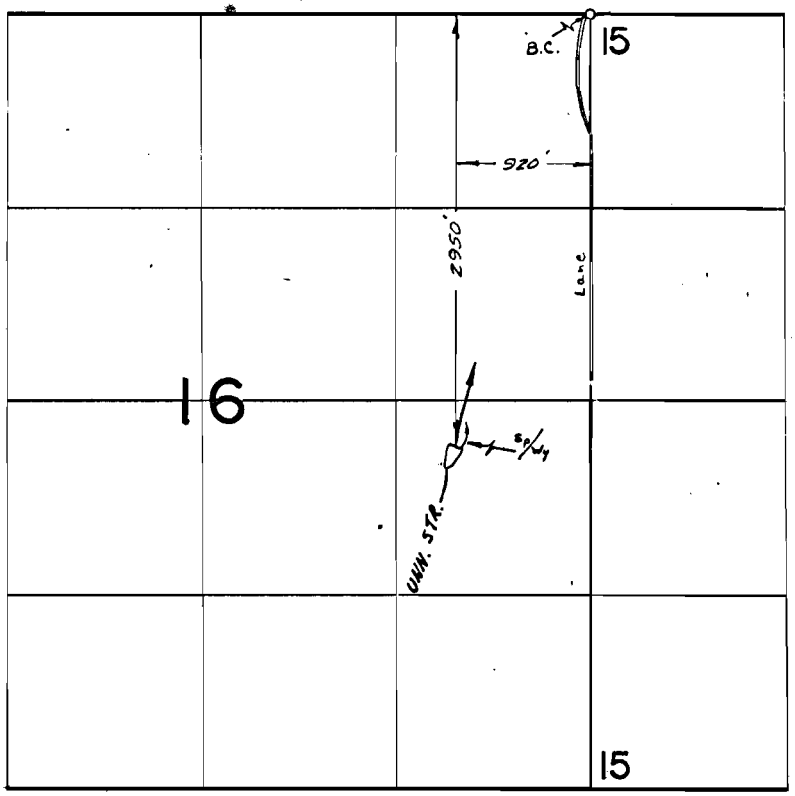

FINAL PROOF SURVEY

UNDER

Application No. R-43455 (43898) Permit No. R-4997 (32556)

IN NAME OF

CHESTER A. STRINGER JR.

Surveyed MAY 30, 1973, by R. G. MUCKEN

DFQ-ILL-122