


T.5 S. R.3 W. W.M.

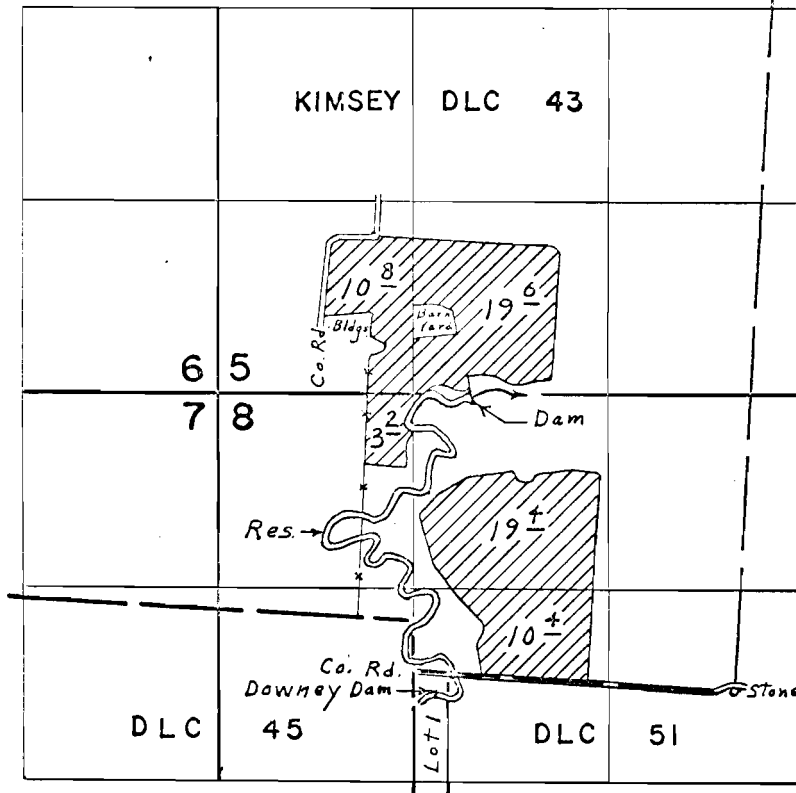

Div pt. Loc: 20 ft. S. of 1710 ft. E. from NW cor. Sec. 8

FINAL PROOF SURVEY
UNDER

R-44508 R-5270
Application No. 44509 Permit No. 33309...
IN NAME OF

FRANK ARMENTROUT

Surveyed March 23, 1973, by L. E. Gould