


T.2S. R.5W. W.M.

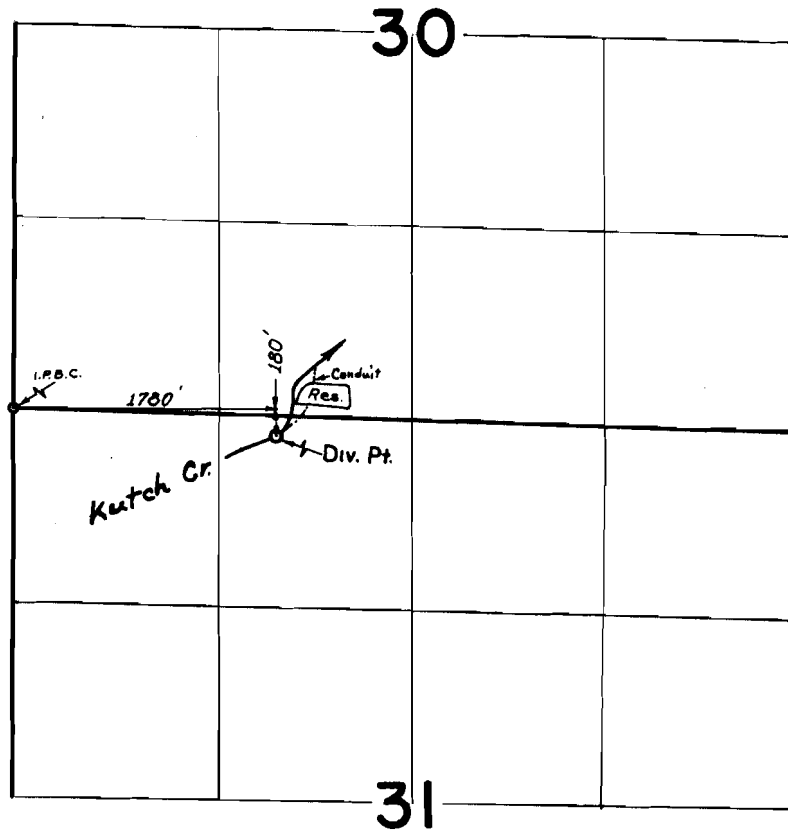

FINAL PROOF SURVEY
UNDER

Application No. 46914 Permit No. 35097
R-46913 R-5626
IN NAME OF

BRYCE G. & BARBARA J. MITCHELL

Surveyed APRIL 25, 1973, by R.G. MUCKEN