


T. 24 S. R. 7 W. W.M.

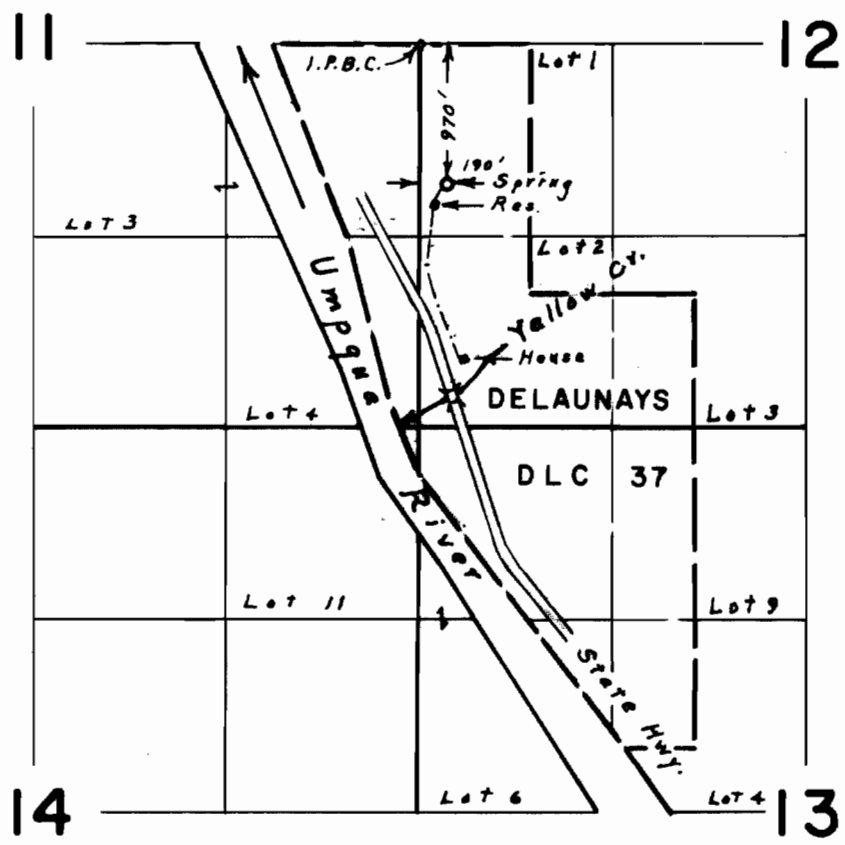

FINAL PROOF SURVEY
UNDER

Application No. 49169 Permit No. 36417
IN NAME OF

ADA M. McHUGILL

Surveyed April 2, 1973, by L. E. Gould