


T.13S., R.6W., W.M.

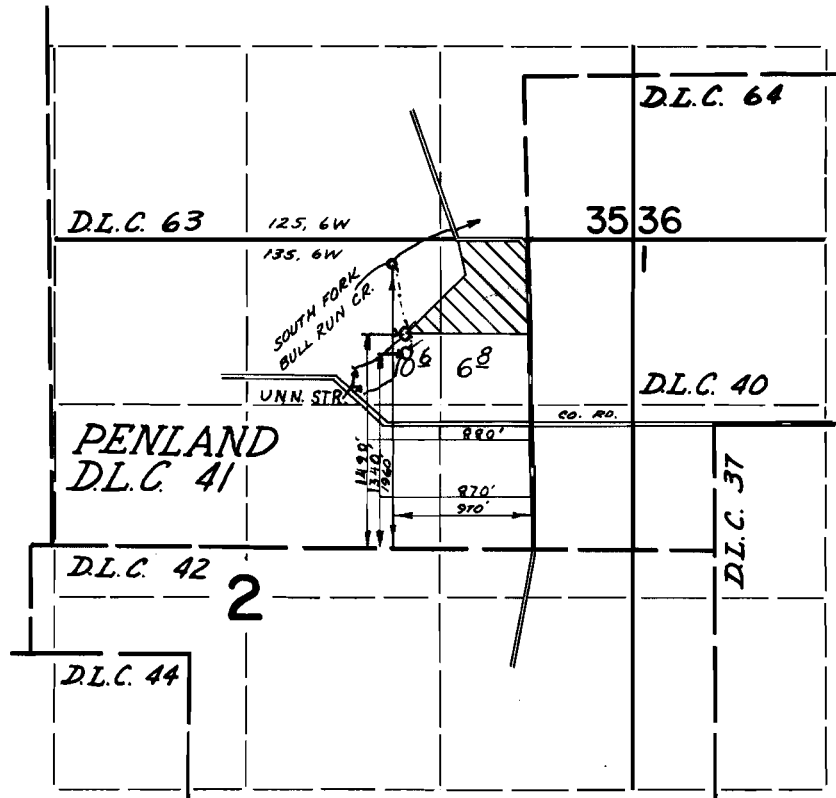

FINAL PROOF SURVEY UNDER

Application No. ~~48556~~ 44256 Permit No. ~~36441~~ 33055
IN NAME OF

L. F. BOGGS

Surveyed MARCH 28 1973 by D. NORBY
APRIL 21 76 C. R. KING