


T.13S., R.6W., W.M.

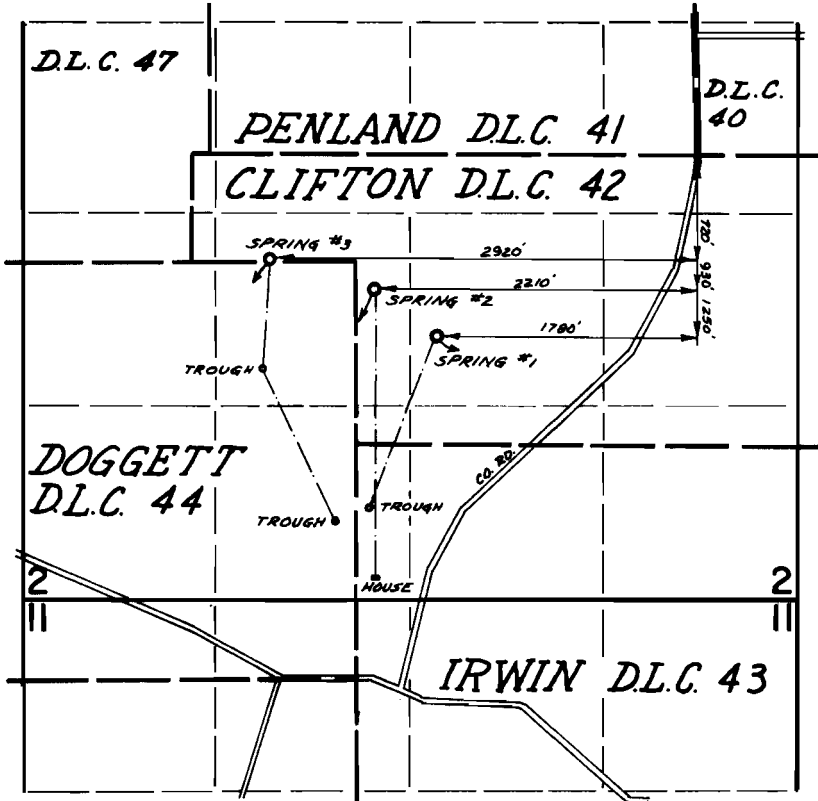

FINAL PROOF SURVEY
UNDER

Application No. 45380 Permit No. 33879
IN NAME OF

T. R. PARK

Surveyed APRIL 3 1973, by D. NORBY