


T.14S., R.8W., W.M.

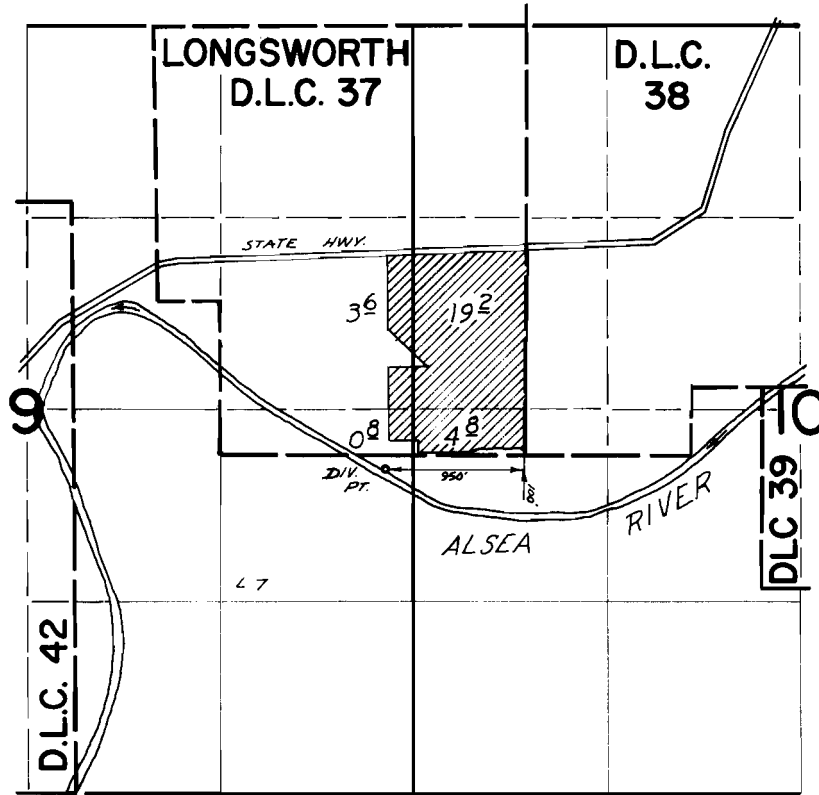

FINAL PROOF SURVEY UNDER

Application No. 45916 Permit No. 34304
IN NAME OF

Lewis E. & Margaret M. Townsend

Surveyed APRIL 27 1973, by D. NORBY