


T. 12 S., R. 6 W., W.M.

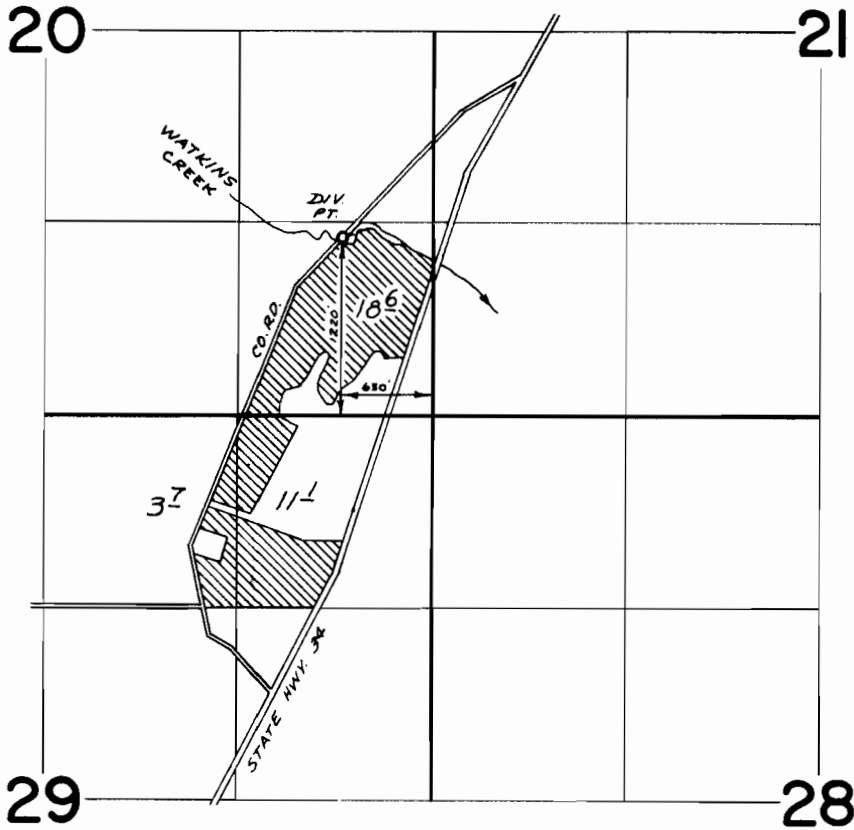

FINAL PROOF SURVEY UNDER

Application No. 46473 Permit No. 34407
IN NAME OF

M.A. ANDERSON

Surveyed MARCH 29 1973, by D. NORBY