


T.13S., R.6W., W.M.

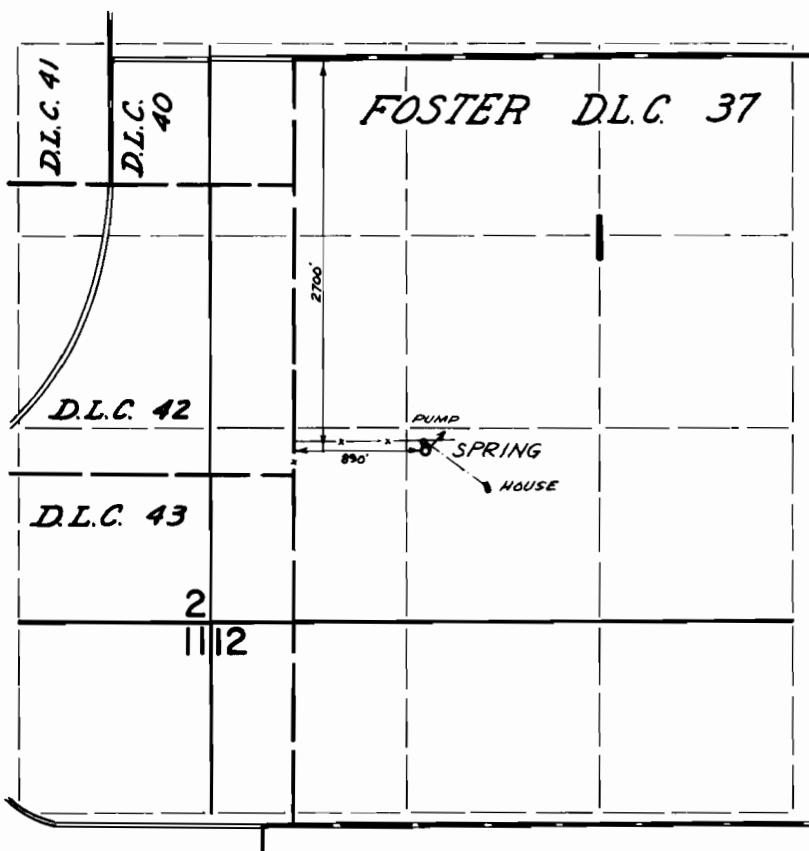

FINAL PROOF SURVEY
UNDER

Application No. 46681 Permit No. 34873
IN NAME OF

MANLY THOMPSON

Surveyed April 3 1973, by D. Norby