


T.11S., R.5W., W.M.

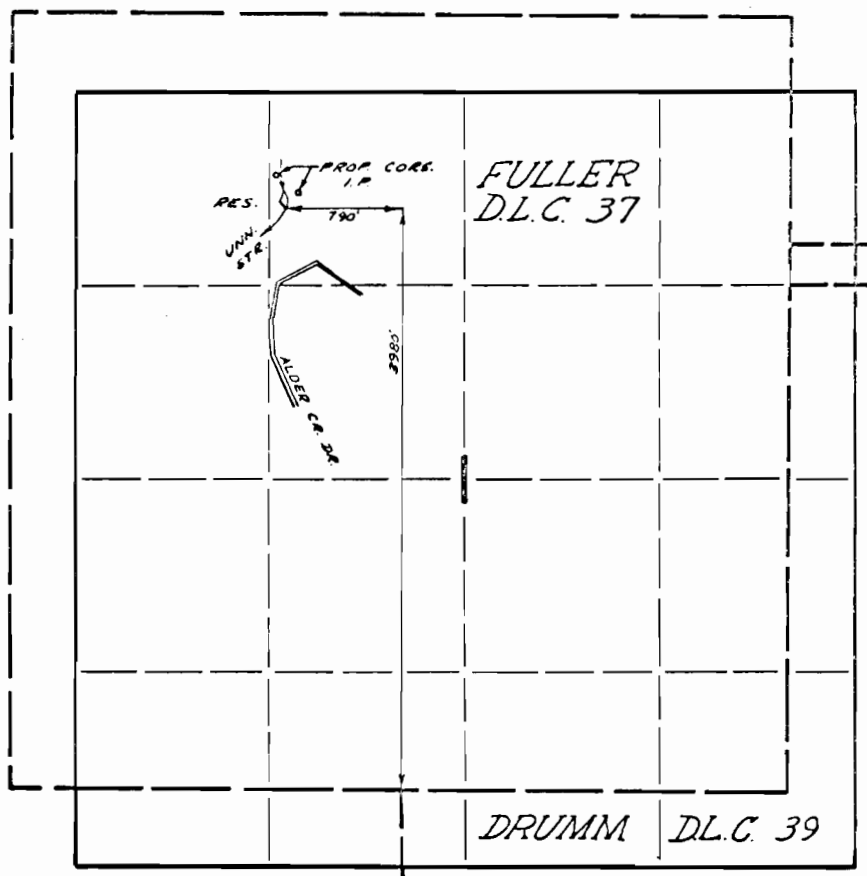

FINAL PROOF SURVEY
UNDER

R-47300 R-5699
Application No. 47301 Permit No. 35441
IN NAME OF

NORMAN R. & ALICE D. GLASS

Surveyed APRIL 3, 1973, by D. NORBY