


T.11S., R.5W., W.M.

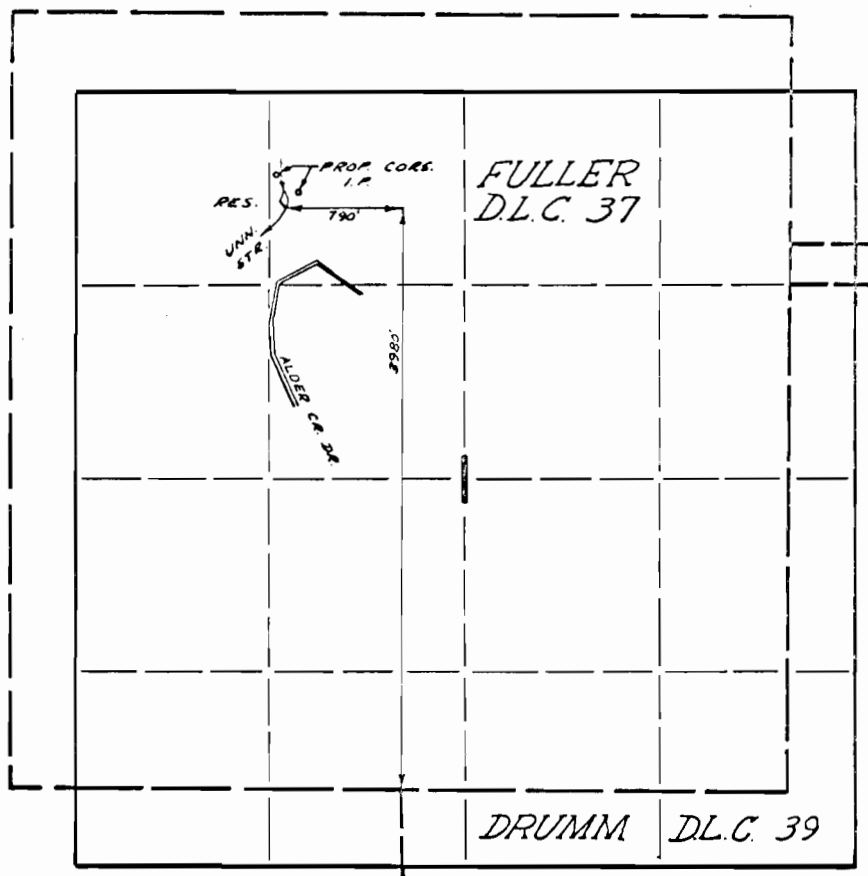

FINAL PROOF SURVEY
UNDER

Application No. R-47300 Permit No. R-5699
47301 35441
IN NAME OF

NORMAN R. & ALICE D. GLASS

Surveyed APRIL 3 1973, by D. NORBY