


# T.2S. R.IE. W.M.

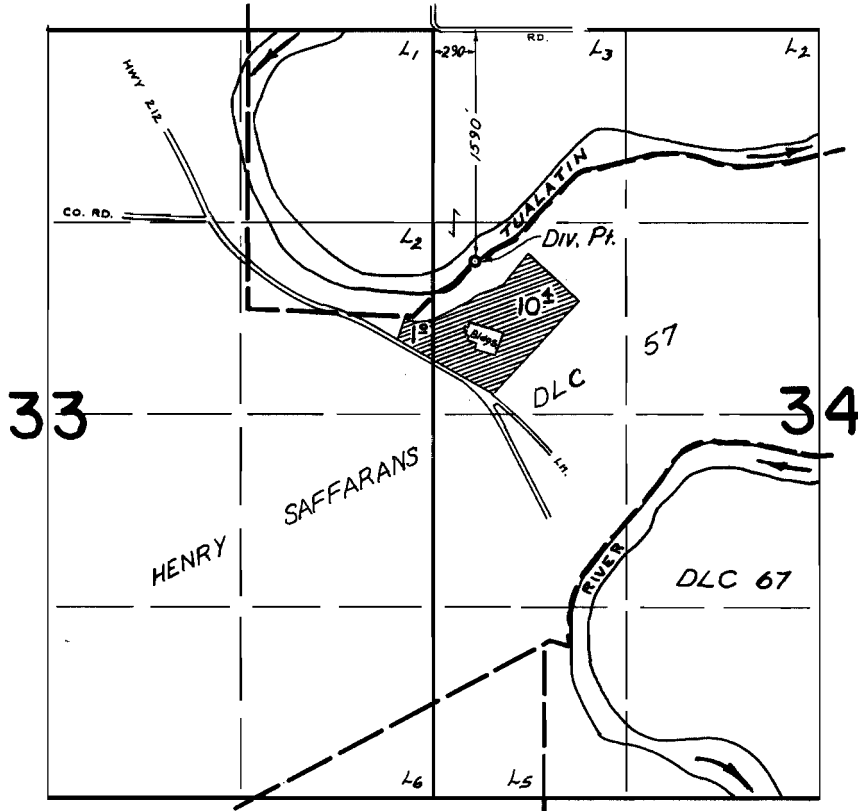

## FINAL PROOF SURVEY UNDER

Application No. 44466 Permit No. 33497  
IN NAME OF

Richard C. & Carol C. Smelser

Surveyed SEPT. 4, 1974, by L.E. GOULD