


T.5N., R.10W., W.M.

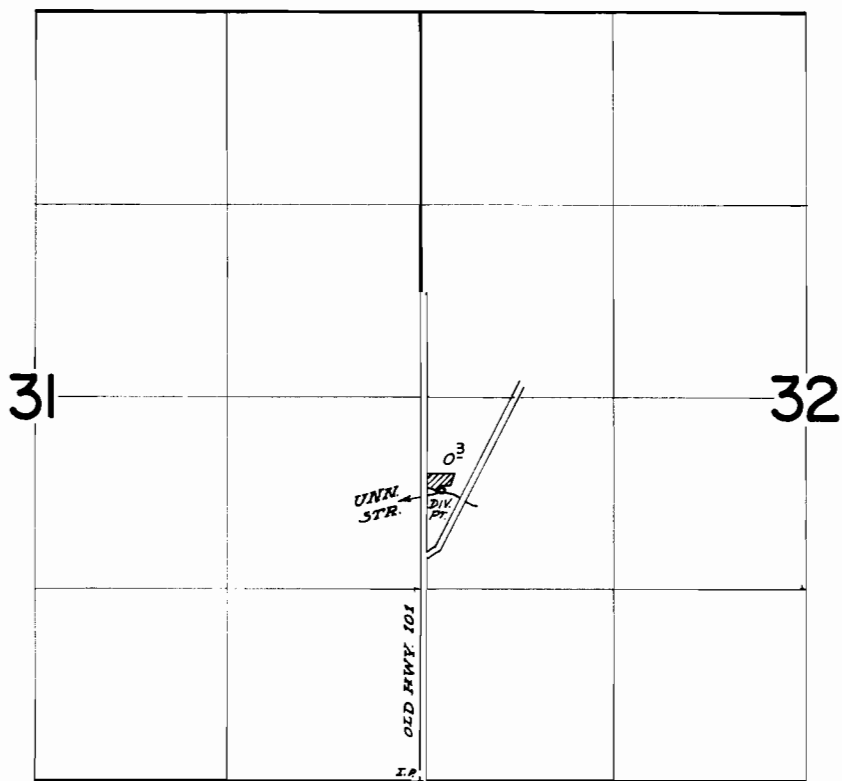

DIV. PT. LOCATED: 1990' N & 140' E FROM SW COR SEC. 32.

FINAL PROOF SURVEY UNDER

Application No. 44950 Permit No. 33598
IN NAME OF

Eugene Allegretto

Surveyed May 1 1973, by R. Mucken
June 5 74, D. Norby