


T.27S., R.6W., W.M.

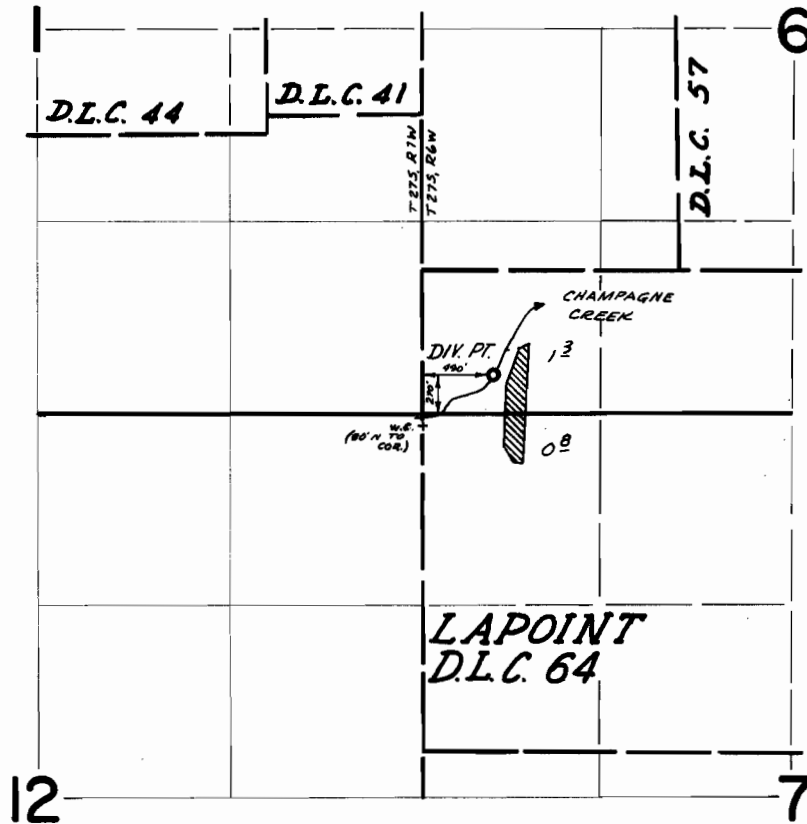

FINAL PROOF SURVEY
UNDER

Application No. 44652 Permit No. 33432
IN NAME OF

OTTO C. HUFFMAN

Surveyed Sept. 12 1973, by D. Noeby