


# T. 24 S. R. 7 W. W.M.

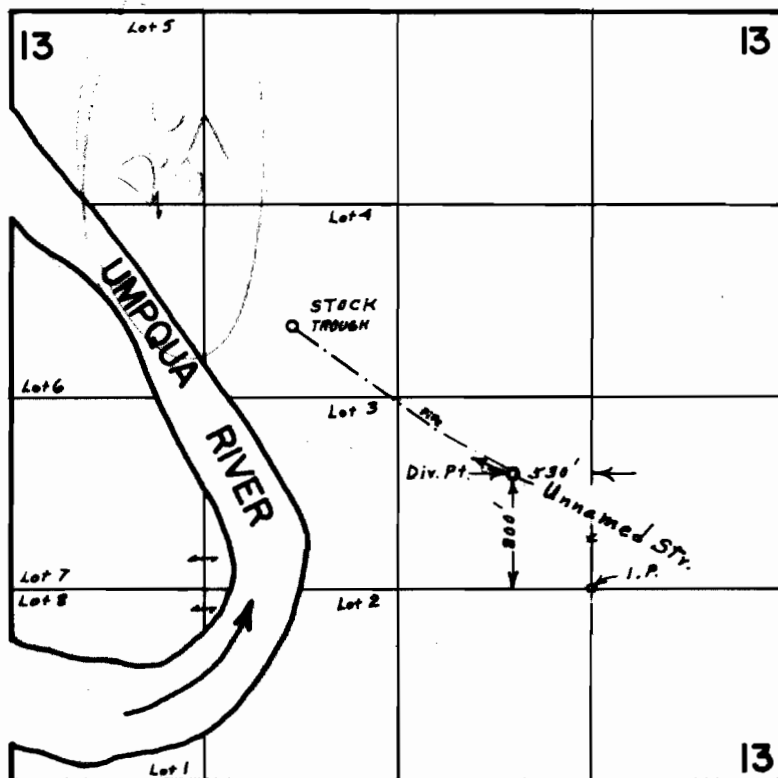

## FINAL PROOF SURVEY UNDER

Application No. 47291 Permit No. 35494  
IN NAME OF

ROBERT L. JULYAN

Surveyed APR 4 19.73, by LE. GOULD