


# T.38S.,R.5W.,W.M.

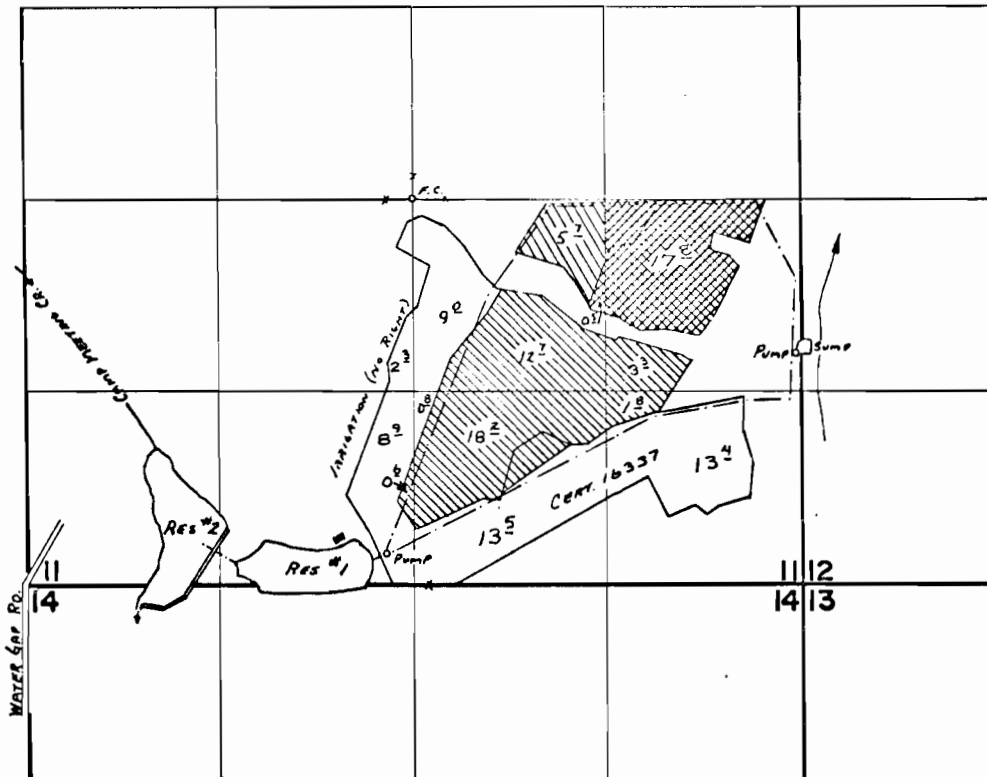

Dam Loc: 2420'S AND 1400'W FROM C/4 SEC.11  
 Sump Loc: 1040'S AND 2600'E FROM C/4 SEC.11

- SUPPLEMENTAL A-37246
- SUPPLEMENTAL A-37246 & A-6-4762
- PRIMARY A-6-4762

## FINAL PROOF SURVEY UNDER

R-37246                      R-3942  
 37247                      29336  
 Application No. G-4762. Permit No. G-4486.  
 IN NAME OF

.....MADRONE RANCH.....

Surveyed OCT. 10. 1974, by ...L. T. ...