


T.35 & 36 S. R. 7 W. W.M.

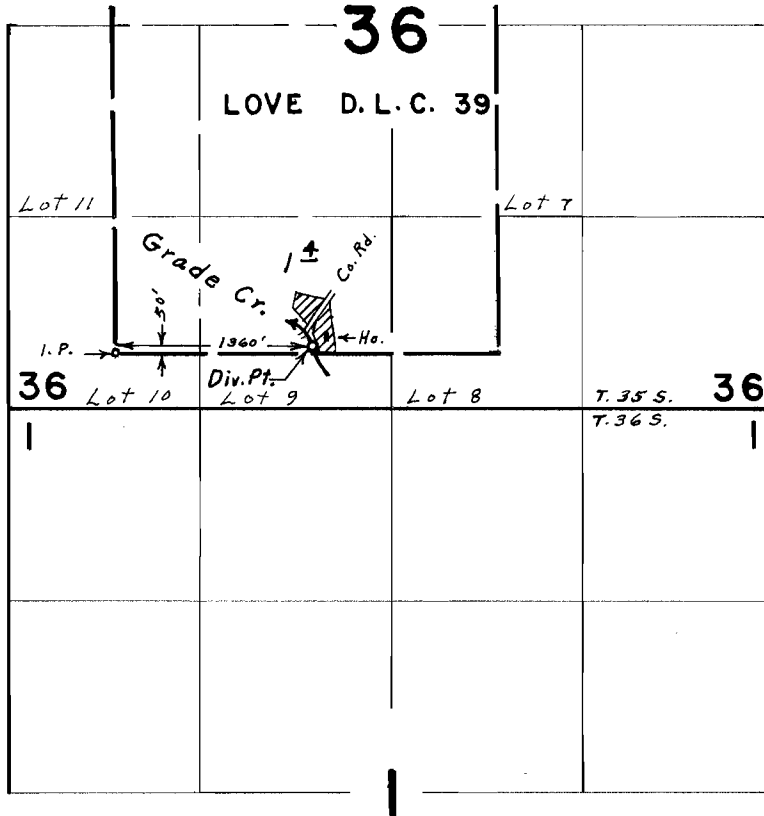

FINAL PROOF SURVEY

UNDER

Application No. 39102 Permit No. 29109

IN NAME OF

HOWARD N. & JESSIE L. WEST

Surveyed April 28, 1970, by L. E. Gould