T.38S.,R.5W.,W.M.

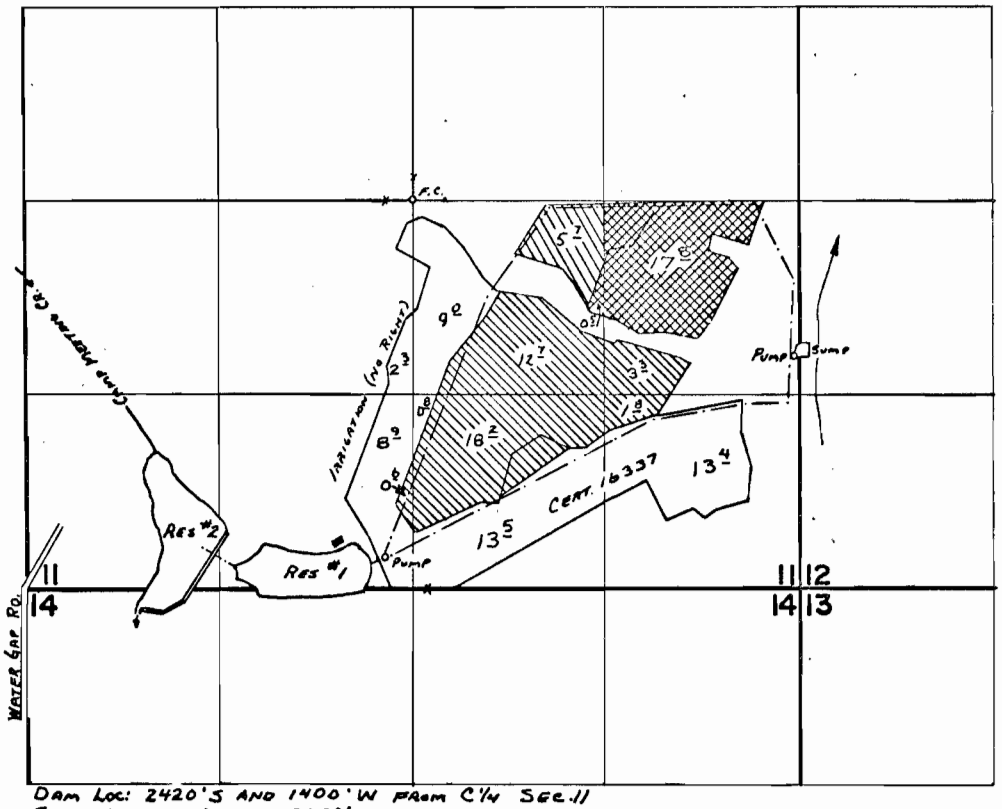

DAM LOC: 2420'S AND 1400'W FROM C'/4 SEC.11
SUMP LOC: 1040'S AND 2600'E FROM C'/4 SEC.11

- SUPPLEMENTAL A-37246
- SUPPLEMENTAL A-37246 & A-G-4762
- PRIMARY A-G-4762

FINAL PROOF SURVEY

UNDER

R-37246 R-3942
37247 29336
Application No. G-4762 Permit No. G-4486

IN NAME OF

MADRONE RANCH

Surveyed Oct. 10 1974, by L. Toll

PTS 1974W