


Tract T
lots 1, 2, 3, 4

RECEIVED
JUL 29 1970
STATE ENGINEER
SALEM, OREGON

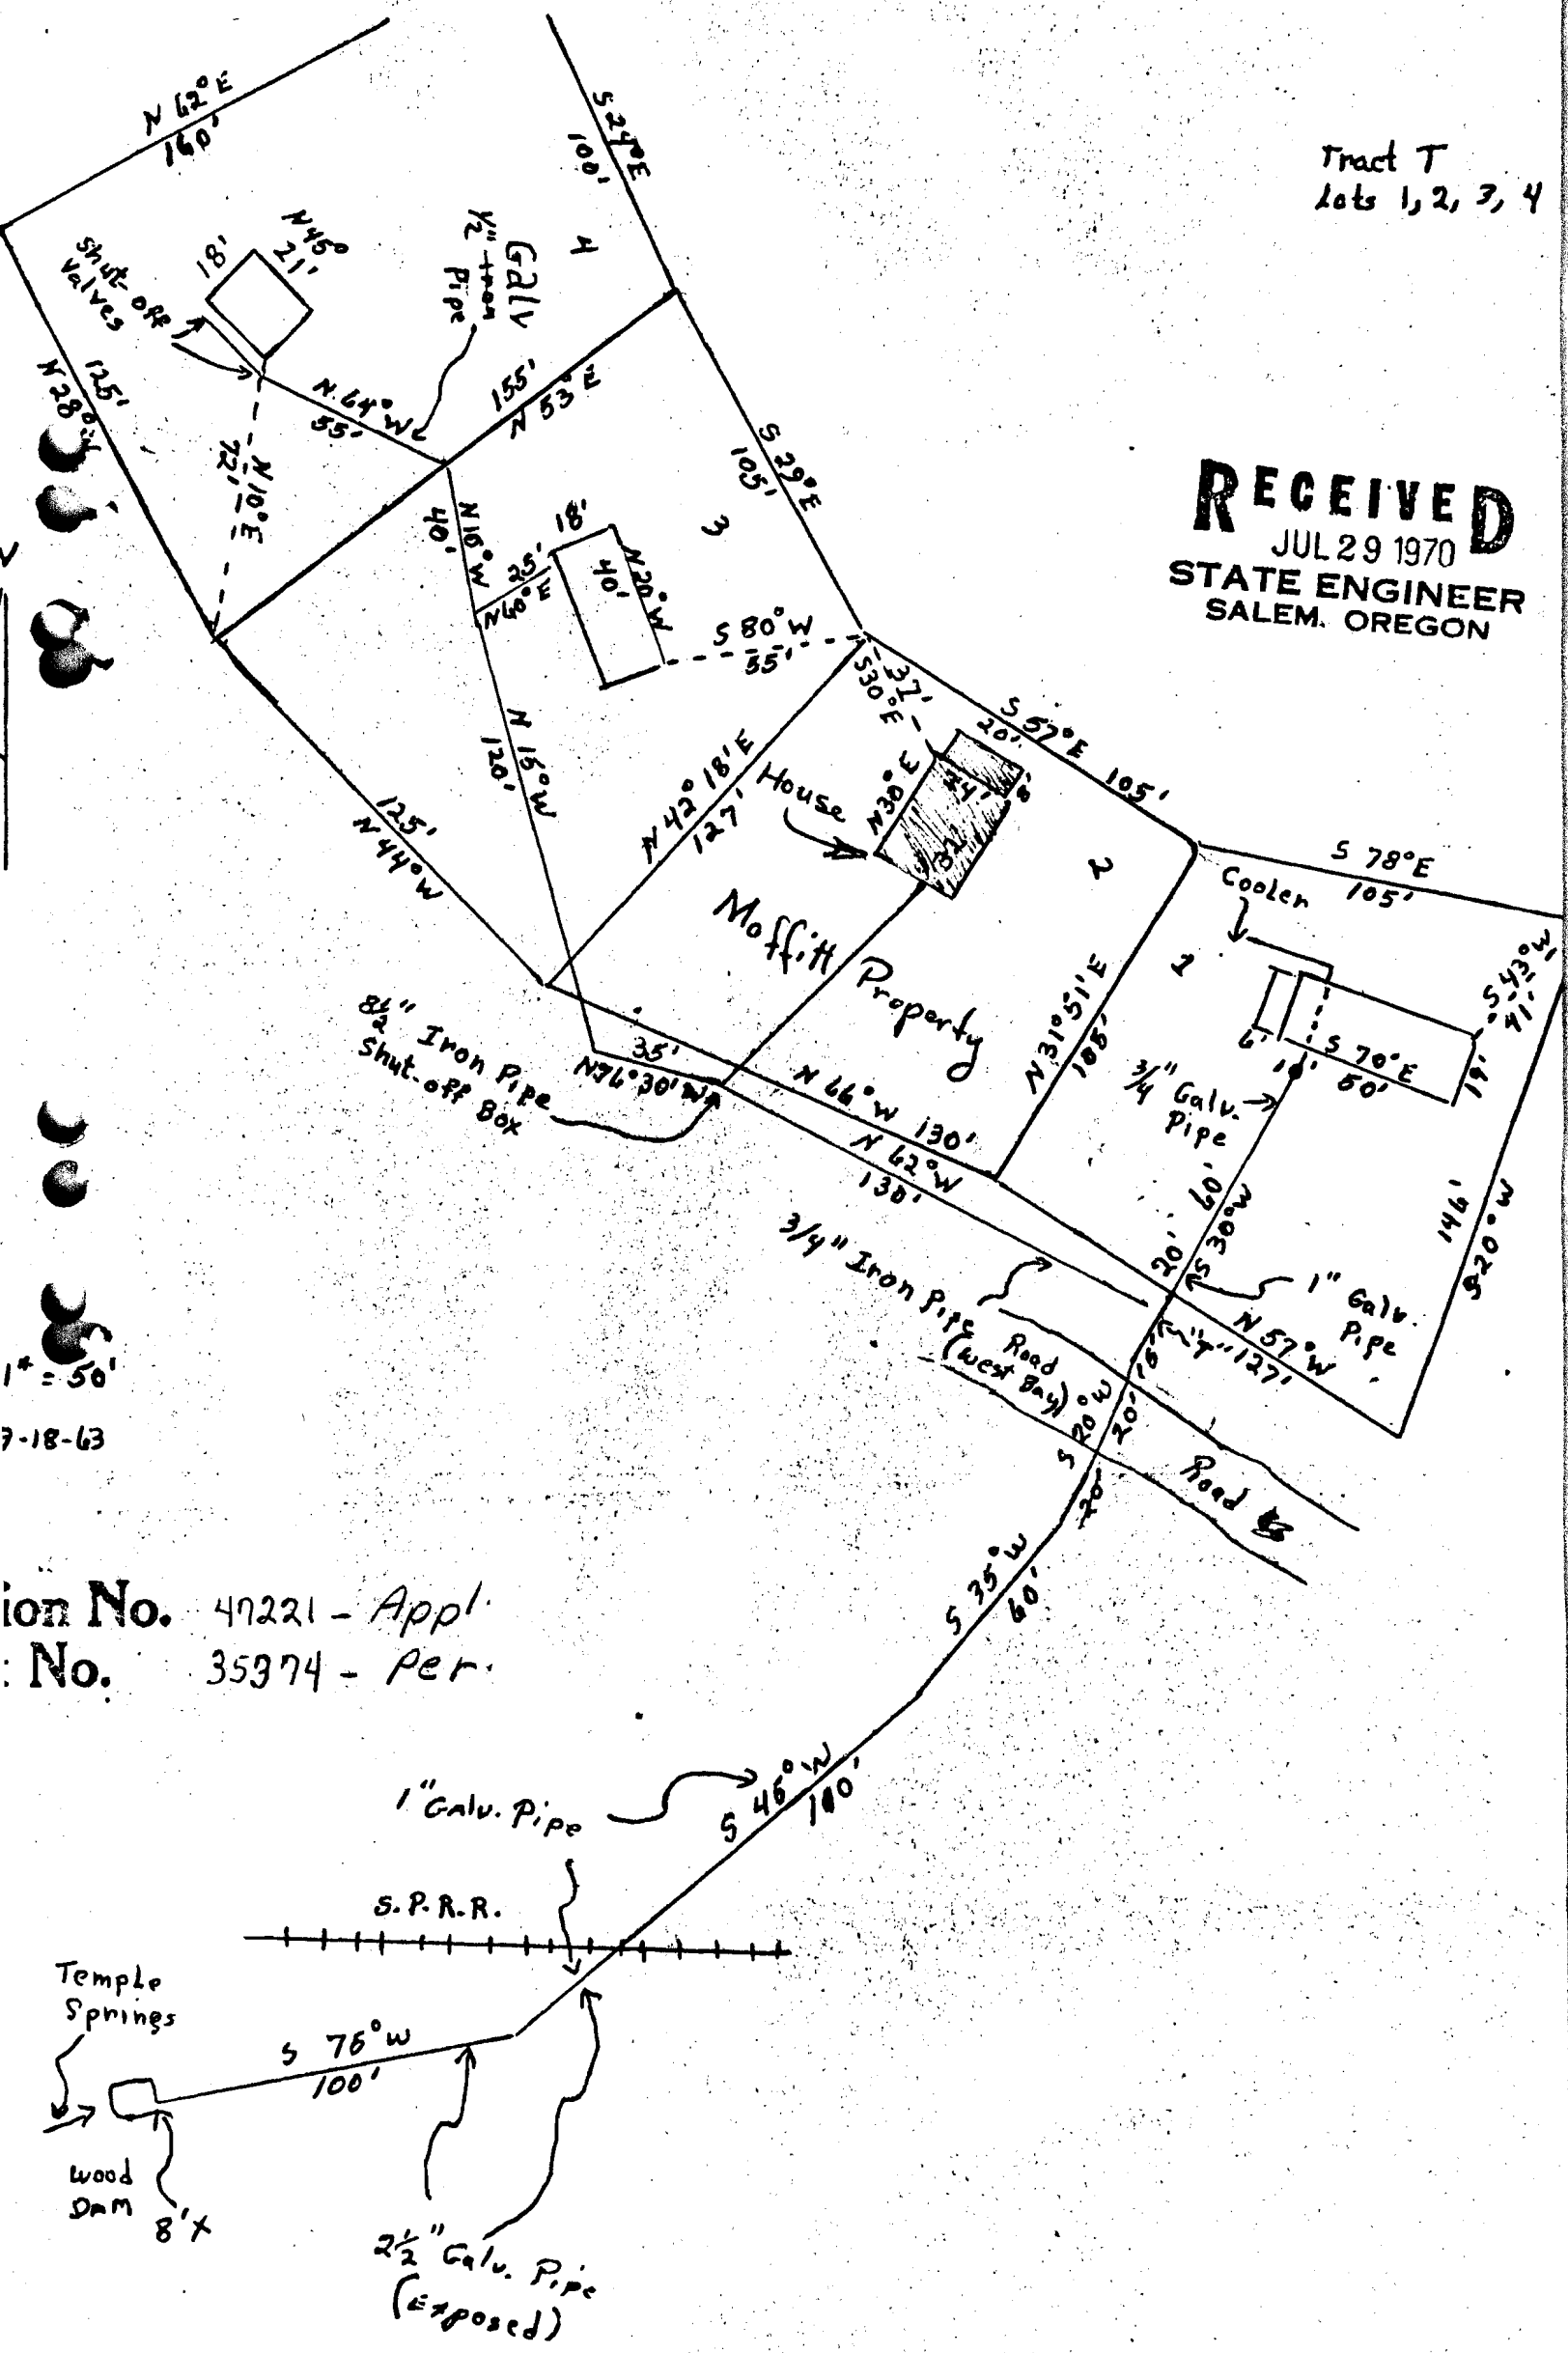

ion No. 47221 - Appl.
No. 35974 - Per.