


T.15S.R.4W.W.M.

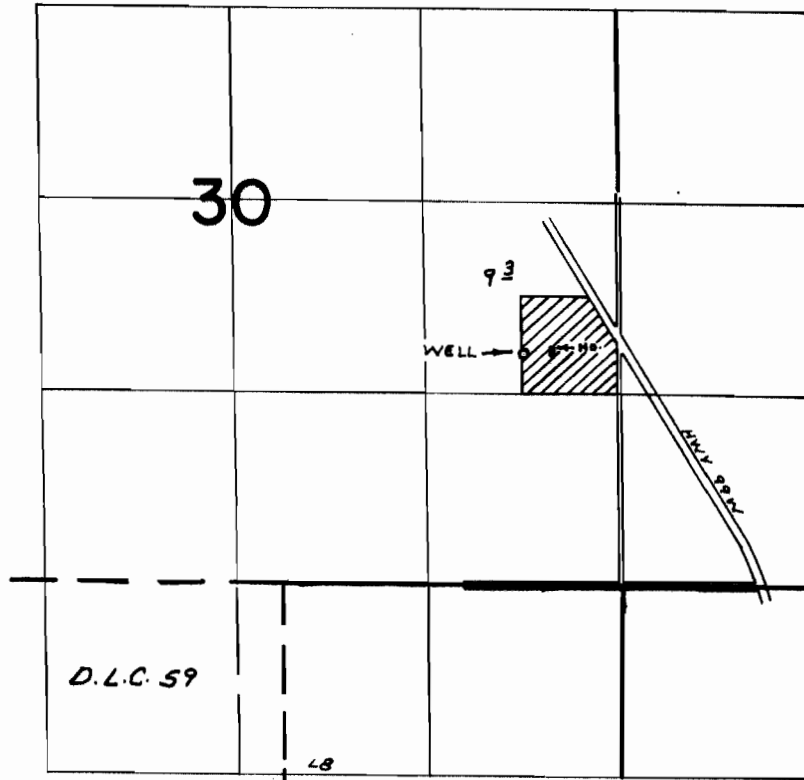

WELL LOC: 1580' N & 650' W. FROM S.E. COR. SEC. 30

FINAL PROOF SURVEY
UNDER

Application No. G-5012 Permit No. G-4725
IN NAME OF

JOHN RICHARD E. ELYOSE GRACE KERR

Surveyed SEPT. 28, 1973, by R. MUCKEN