


T.11S., R.4W., W.M.

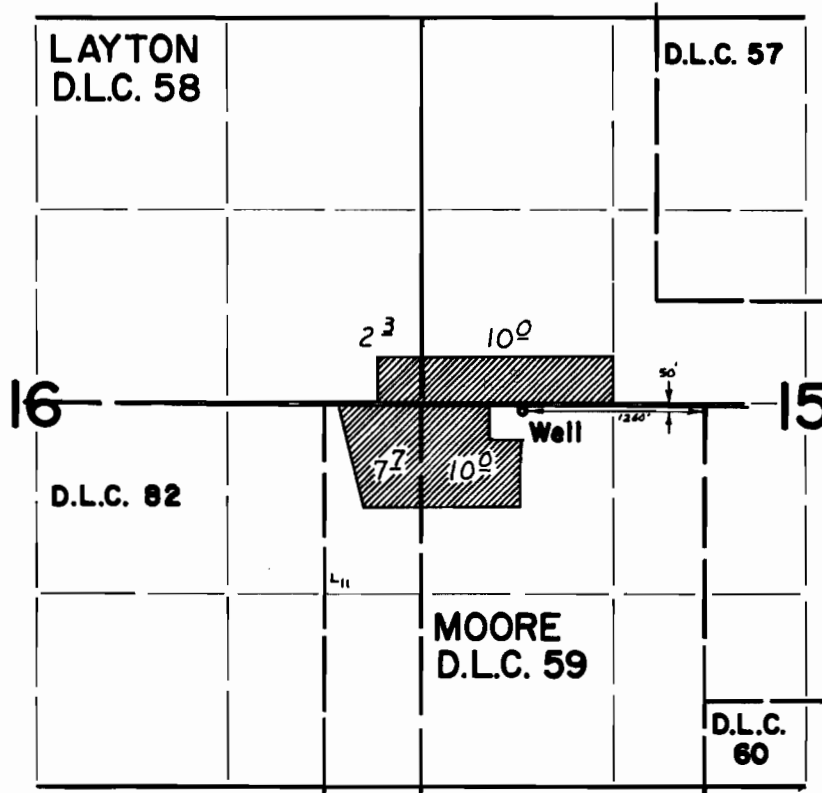

FINAL PROOF SURVEY
UNDER

Application No. G-3869 Permit No. G-3642
IN NAME OF

ROBERT N. CLAUSEN

Surveyed Oct. 2, 1973, by D. Norby