T. 15 S.R.4W. W.M

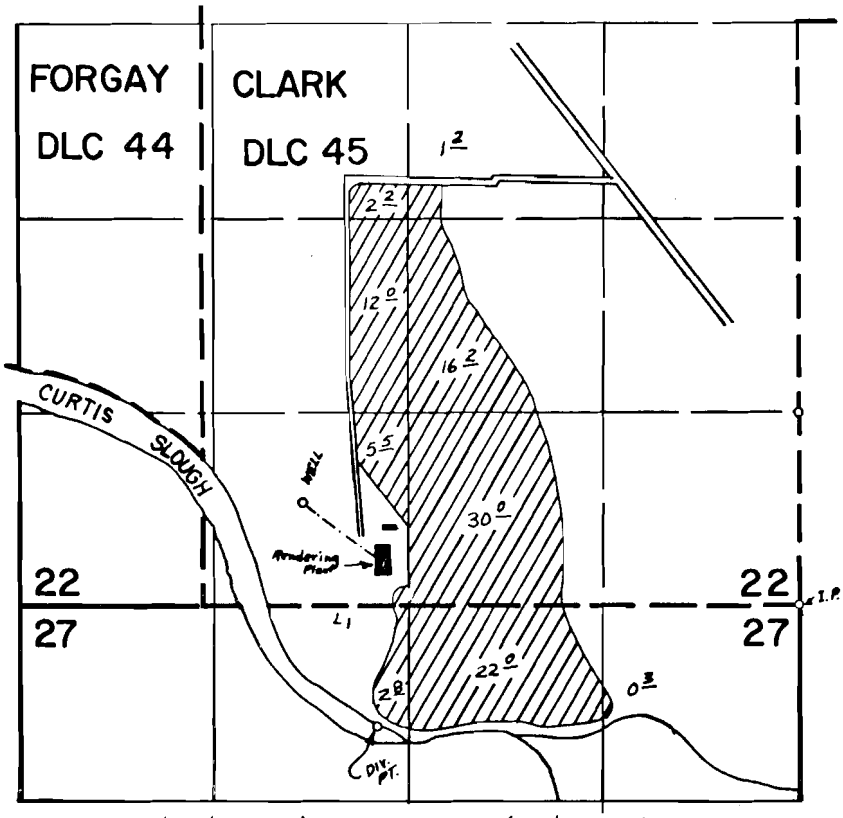

WELL 730' N ¢ 3350' W , DIV. PT. 810' S ¢ 2850' W FROM SE COR. SEC 22

FINAL PROOF SURVEY
UNDER

Application No. G-4163 44328 Permit No. G-3914 33102

IN NAME OF

EUGENE CHEMICAL & RENDERING WORKS

Surveyed OCT 22 19 73, by R.G. MUCKEN

DFM-1JJ-29 P.C.