


T.11S., R.2W., W.M.

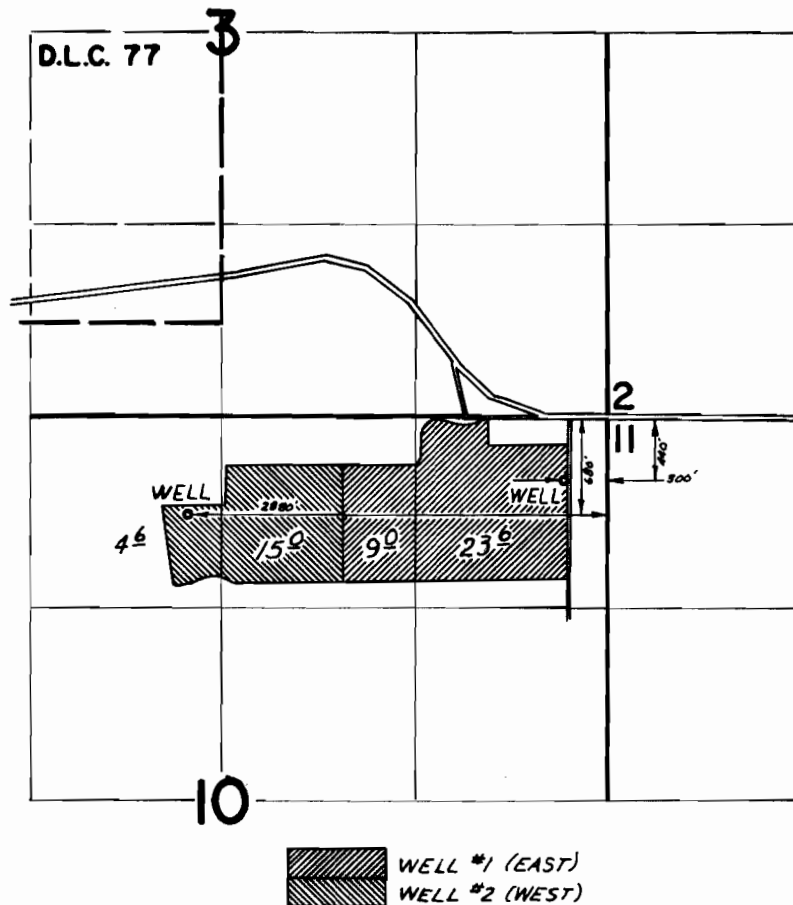

FINAL PROOF SURVEY
UNDER

Application No. G-4727 Permit No. G-4447
IN NAME OF

RALPH L. AND DONNA BENDER

Surveyed JUNE 18, 1973, by D. NORBY