


T.13S.R.1W.W.M.

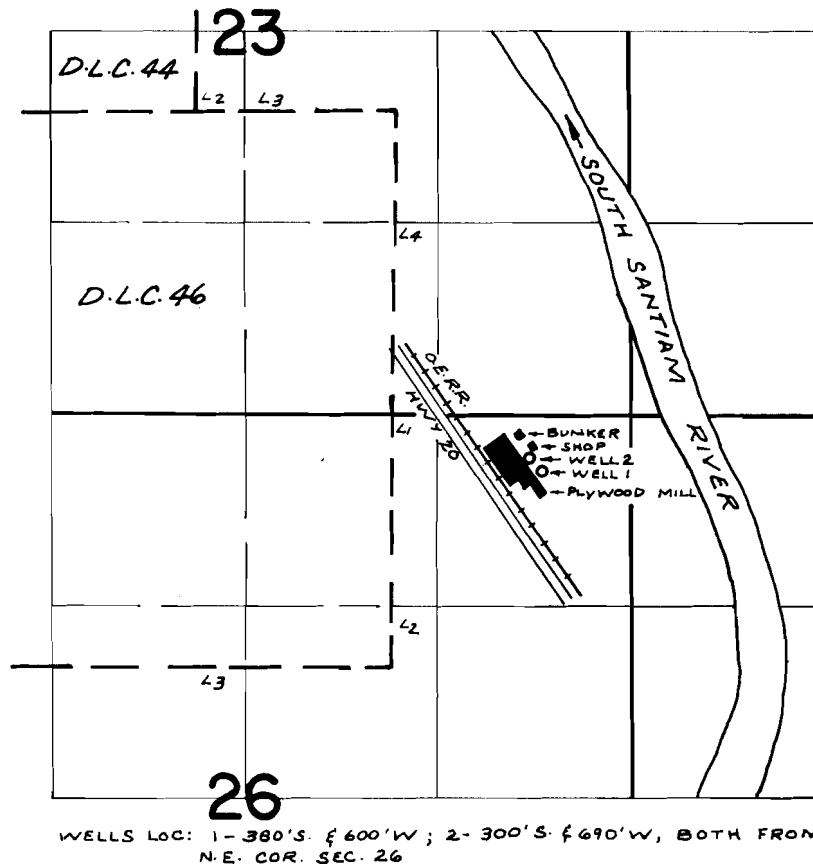

FINAL PROOF SURVEY
UNDER

Application No. G-5143 Permit No. G-4876
IN NAME OF

BOISE CASCADE CORPORATION

Surveyed MAY 9, 1973, by R. MUCKEN